


HOT FILE Greenwood KANSAS

SEC. 19 TWP. 22 S R. 11 E
 WELL NO. (Clopton-Harris Waterflood)
 # W-5 S. B. Harris FARM

COMPANY Sunray Mid-Continent (DEVELOPMENT)

CONTRACTOR Jackman & Jackman
 DeMalorie-Sowder Field

440 FT. FROM N. LINE
 FT. FROM S. LINE
 FT. FROM E. LINE
 50 FT. FROM W. LINE
 of Sec.
 NW NW NW

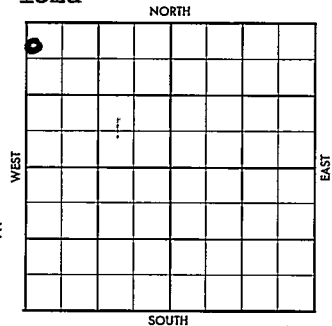

ELEVATION REPORT

1957
 2/6 MIRT 2100' Bartlesville Test No FR
 (DR#26-1957)
 2/7 RURT
 2/8 Spud 2-7-57
 8-5/8" @ 84
 TD 85'. WOC
 2/11 Drlg. 1650'
 2/12 TD 2091'. Fishing.
 2/13 TD 2091' "
 2/14 TD 2091'. WOC - 4 1/2" csg @ 2067'
 2/15 TD 2091'. WOC - 4 1/2" csg.
 2/18 TD 2091'. Drlg. plug.
 2/19 TD 2091'. CO
 2/20 TD 2091'. Prep to complete.
 2/21 TD 2091'. Water Injection Well

Open hole 2063-2091' Bartlesville Zone Complete (DR#37-1957)

COMPLETED