


# LOT FILE Greenwood KANSAS

SEC. 19 TWP. 22 S R. 11 E  
 WELL NO. (Clopton-Harris W<sub>t</sub>r.Flood)  
 # W-7 S. B. Harris FARM

COMPANY Sunray Mid-Continent (DEVELOPMENT)

CONTRACTOR Hart & Cross  
 Jackman & Jackman  
 Demalorie-Sowder Fld.

1650 FT. FROM N. LINE  
 FT. FROM S. LINE  
 FT. FROM E. LINE  
 330 FT. FROM W. LINE

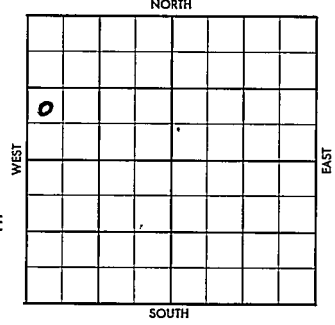

of NW/4 of Sec.  
 NW SW NW

1957 ELEVATION REPORT

2100' Bartlesville Test  
 12/2 Spudded 11-29-57 8-5/8" @ 118/75  
 Drlg. 1100' (DR#233)  
 12/3 Drlg. 1750' (FR Tkt)  
 12/4 Coring @ 2030'  
 12/5 ~~WF~~ TD 2080' Rng. EL  
 12/6 TD 2080'. P & A (DR#237)