


Harvey

KANSAS

SECTION 2 TOWNSHIP 22 RANGE 2E

WELL NO. #1 Maze

COMPANY Adair

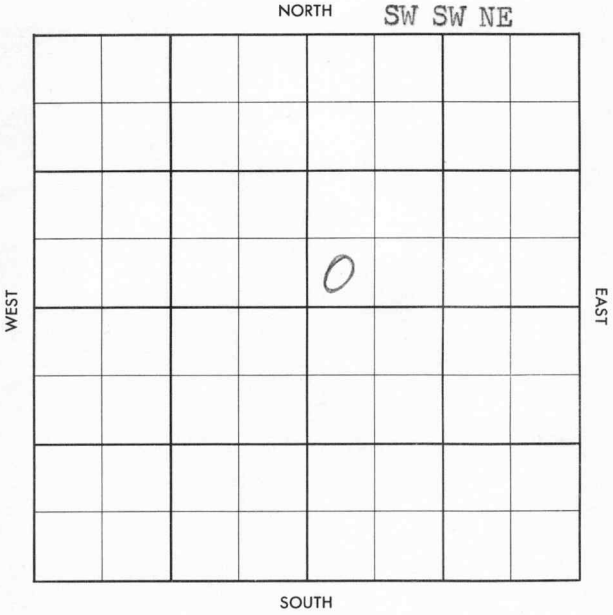

# WILDCAT

FORM 513 SUNRAY

County Harvey

Elev. \_\_\_\_\_

Sec. 2

Twp. 22

22

Rgs. 2E

Company Adair

Farm Name Maze

No. 1

TOPS	DEPTH	LOG	DATUM	Loc. in Sec.				
Anh.	2090			SW SW NE				
Tp.								
H.								
Tr.								
Dg.								
Bl.								
L.				Geol. _____				
K.C.				Contr. _____				
B.K.C.				Co. Tools _____				
Ce.				Pool _____				
C.				Wildcat _____				
M.				<table border="1" style="width: 100%; height: 100%; border-collapse: collapse;"> <tr> <td colspan="2" style="text-align: center;">FIRST REPORT</td> </tr> <tr> <td style="text-align: center;">○</td> </tr> <tr> <td style="text-align: center;">JUN 26 '57</td> </tr> </table>	FIRST REPORT		○	JUN 26 '57
FIRST REPORT								
○								
JUN 26 '57								
M.								
K.								
Mz.								
Ma.								
V.								
S.								
S.								
A.								
R.								
PE.								
G.								
T.D.								

Date Comm. 6-19-57

8" @ 202/150, Drlg. 2400

~~10~~

County Harvey Elev. 1438  
 Sec. 2 Twp. 22 Rge. 2E  
 Company Adair  
 Farm Name Maze No. 1

TOPS	DEPTH	LOG	DATUM
Anh.	2090		
Tr.			
H.			
Tr.			
Dg.			
B.L.			
L.		2097	
K.C. <u>Burg</u>		2725	
B.K.C.			
Ce.			
C.		2765	
M.			
M.			
K.		2926	
Mz. <u>Hunt</u>		3049	
Ma.		3122	
V.		3131	
S.			
S.			
A.			
R.			
Pe.			
G.			
T.D.	3152		

Loc. in Sec. SW SW NE  
 Geol. \_\_\_\_\_  
 Contr. \_\_\_\_\_  
 Co. Tools \_\_\_\_\_  
 Pool \_\_\_\_\_  
 Wildcat \_\_\_\_\_

**ABANDONED**  
 0  
 JUL 10 '57

Date Comm. 6-19-57  
8" @ 202/150, Drlg. 2400 JUL 3 '57 - JUL 10 '57

De'a (Hunt)