

Kansas

Map No. _____ Sec. 2 Twp. 22 R. 3E


Well No. 1 Farm _____
W.A. Cameron Company

300 Ft. from N. Line

_____ Ft. from S. Line

990 Ft. from E. Line

_____ Ft. from W. Line

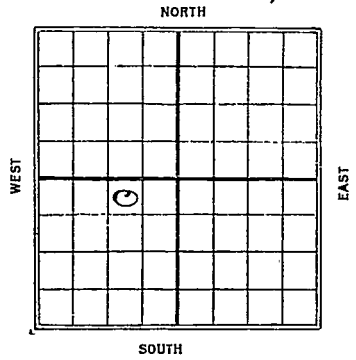

1927

Date	REPORT
<u>2/9</u>	<u>Location</u>
<u>2/16</u>	—
<u>2/23</u>	—
<u>3/2</u>	—
<u>3/9</u>	—
<u>3/16</u>	<u>Moving in rig</u>
<u>3/23</u>	—
<u>3/30</u>	<u>Rigging up</u>
<u>4/6</u>	—
<u>4/13</u>	<u>Spud</u>
<u>4/20</u>	<u>Spud + S.D.</u>
<u>4/27</u>	—
<u>5/4</u>	—
<u>5/11</u>	—
<u>5/25</u>	—
<u>6/1</u>	—
<u>6/8</u>	—
<u>6/15</u>	—
<u>6/22</u>	—
<u>6/29</u>	—
<u>7/6</u>	—
<u>7/13</u>	—

7/20 - Dredg 1380-
8/27 - " 2100
8/3 - " 2315
8/10 - " 2400
8/17 - fishing tools 2435
8/23 _____
8/31 - T.D. 2435 - fishing
9/7 _____
9/14 _____
9/20 - T.D. 2435 - Shut down.
9/28 - Run 6" - 2445 -
10/5 - T.D. 2445 - C.O.
10/12 - Chat 2595-2604 - H.F.W.
drilling 2680-
10/19 - T.D. 2736 - S.D.
10/26 _____
11/2 - T.D. 2736 - D.V.A.

24 KANSAS Map No. Sec. 2 Twp. 22 R. 27

Well No. 1

V.A. Cameron Company

Contractor

SECTION PLAT

300 Ft. from N. Line

Ft. from S. Line

790 Ft. from E. Line

Ft. from W. Line

	o		

FIRST REPORTS

Location

Rig up

Drilling and Remarks:

RECORD

Cased in., ft.

Sand

Gas

Oil

Total Depth

PRODUCTION

1st 24 hrs. Nat.

1st 24 hrs. after shot

Gas Cu. Ft.

Dry Hole

Abandoned

Date

FEB 9 1927

S. J. LEWIS

Scout

Map No. 24 **KANSAS** Sec. 2 Twp. 22 R. 3E

Well No. 1

H. C. Cameron Company

Contractor

SECTION PLAT

300 Ft. from N. Line

_____ Ft. from S. Line

990 Ft. from E. Line

_____ Ft. from W. Line

	0		

ABANDONED

Location _____

Rig up _____

Drilling and Remarks:

T 2736

D & A

RECORD

Cased _____ in., _____ ft.

Sand _____

Gas _____

Oil _____

Total Depth _____

PRODUCTION

1st 24 hrs. Nat. _____

1st 24 hrs. after shot _____

Gas _____ Cu. Ft.

Dry Hole _____

Abandoned _____

Date

NOV 2

1927

S. J. LEWIS

Scout

R24 KANSAS

MAP NO. _____ SEC. 2 TWP. 27S R. 3E

WELL No. 1 Bon

Canon

COMPANY

CONTRACTOR

SECTION PLAT

ABANDONED

_____ FT. FROM N. LINE

_____ FT. FROM S. LINE

_____ FT. FROM E. LINE

_____ FT. FROM W. LINE

	o		

LOCATION _____

RIG UP _____

DRILLING AND REMARKS:

*D. L. M. 2136
we show
OK*

RECORD

CASED _____ IN. _____ FT.

SAND _____

GAS _____

OIL _____

TOTAL DEPTH 2776

PRODUCTION

1ST 24 HRS. NAT. _____

1ST 24 HRS. AFTER SHOT _____

GAS _____ CU. FT.

DRY HOLE

ABANDONED

DATE

10/19 192 9

SCOUT

no final work
don't cover

IN
EP

KUD