

Greenwood

Map No. *Kansas* Sec. *2* Twp. *22* R. *10*


Well No. *2 Bradford* Farm
Syndicate Oil Company

..... Ft. from N. Line

990 Ft. from S. Line

330 Ft. from E. Line

..... Ft. from W. Line

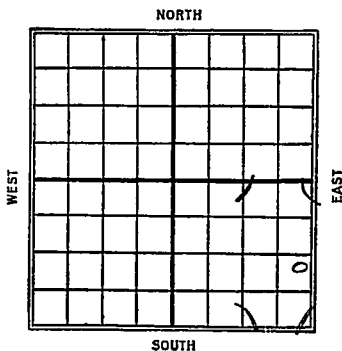

Date
7/26

REPORT

6/9 *Reg up*

6/18

6/25 *Spudding*
6-30 *only 600*

7/8 *Runn. 10" - 1130*

7/15 *Dlg 1775*

7/21 *Inch. 2038-2093*

T.D. 2112. Oil 2049

320/150 bbls.

Alexander

K21 KANSAS
Map No. _____ Sec. *2* Twp. *22* R. *10*

Well No. *2* *Bradfield*

Syndicate Oil Co. Company

Contractor

FIRST REPORTS

SECTION PLAT

_____ Ft. from N. Line

990 _____ Ft. from S. Line

230 _____ Ft. from E. Line

_____ Ft. from W. Line

Location _____

Rig up

Drilling and Remarks:

RECORD

Cased _____ in., _____ ft.

Sand _____

Gas _____

Oil _____

Total Depth _____

PRODUCTION

1st 24 hrs. Nat. _____

1st 24 hrs. after shot _____

Gas _____ Cu. Ft.

Dry Hole _____

Abandoned _____

Date
JUN 9 1926

CHAS. L. SHERWOOD
Scout

Sherwood

Map No. K21 KANSAS Sec. 2 Twp. 22 R. 10


Well No. 2 *Bradfield*
Hydrate old _____ Company

_____ Contractor

COMPLETED

SECTION PLAT

_____ Ft. from N. Line
990 Ft. from S. Line
220 Ft. from E. Line
_____ Ft. from W. Line

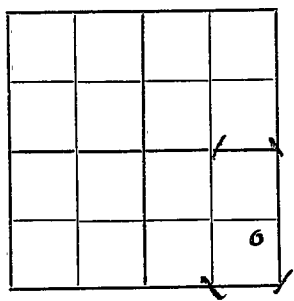

Location _____

Rig up _____

Drilling and Remarks:

OK 2049'

220/150 Bl.

RECORD

Cased _____ in., _____ ft.
Sand 2038-2093'
Gas _____
Oil _____
Total Depth 2112'

PRODUCTION

1st 24 hrs. Nat. _____
1st 24 hrs. after shot. _____
Gas _____ Cu. Ft.
Dry Hole _____
Abandoned _____

Date

JUL 21 1926

CHAS. L. SHERWOOD
Scout