

KANSAS

Greenwood

FORM 51 5M 4-41 PETROL

Section 2 Township 22 Range 10-EWell No. #84 DeMalorieCompany Phillips

Browning Pool

NORTH

WEST

EAST

0

SOUTH

14
15

Sec. 2 Twp. 22 R. 10-E

Well No. #84 Demalorie Farm

Phillips

Company

(Browning)


NORTH

_____ Ft. from N. Line

890 Ft. from S. Line

Ft. from E. Line

330 Ft. from W. Line

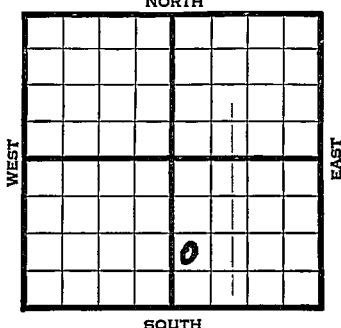

1941	REPORT
5/21	8" - 68'
	Drilg. 860'
5/28	Bart. 2076' B. Bart 2110'
	Arb. 2126' 5" - 2075' RUST.
6/5	" " " "
6/12	Shot 20 qts. 2086-2103' C.O.
6/19	" " " "
6/26	" " " "
7/3	" " " "
7/10	" " " "
7/17	" " " "
	-
7/23	Bart. 2076'
	5" - 2075'
	T.D. 2126'
	Shot 20 qts. 2086-2103'
	Potential 8 bbls., pump.
	36. Gravity
	COMPLETED

Map No. 21 Sec. 2 Twp. 22 R. 10EWell No. 84 DeMaloriePhillips

Company

FIRST REPORT

Contractor

SECTION PLAT

NW SW SE

 Ft. from N. Line890 Ft. from S. Line Ft. from E. Line330 Ft. from W. Line**BROWNING POOL**

Location Rig up

Drilling and Remarks:

8" - 68Dr1g. 860**RECORD**Cased in., ft.Sand Gas Oil Total Depth **PRODUCTION**1st 24 hrs. Nat. 1st 24 hrs. after shot Gas Cu. Ft.Dry Hole Abandoned

Date

MAY 21 1941 19S. J. LEWIS Scout

Map No. 21 Sec. 2 Twp. 22 R. 10EWell No. 84 DeMaloriePhillips Petroleum Company~~COMPLETED~~ Contractor

SECTION PLAT

NW SW SE
Ft. from N. Line890 Ft. from S. Line

Ft. from E. Line

330 Ft. from W. Line

BROWNING POOL

		4	

Location _____

Rig up _____

Drilling and Remarks: *Bar 8 2076**5" @ 2075.**209 to 2086 - 2103**Pump 5 P.X.**26 @ Gr.*

RECORD

Cased _____ in., _____ ft.

Sand _____

Gas _____

Oil _____

Total Depth 2126

PRODUCTION

1st 24 hrs. Nat. _____

1st 24 hrs. after shot _____

Gas _____ Cu. Ft.

Dry Hole _____

Abandoned _____

Date

JUL 23 1941 19S. J. LEWIS Scout