

Greenwald

Map No. *17N* Sec. *2* Twp. *22* R. *10*

Well No. *1* *Shepherd* Farm


Manhattan Oil & Gas Company

NORTH

(Shepherd)

WEST

EAST

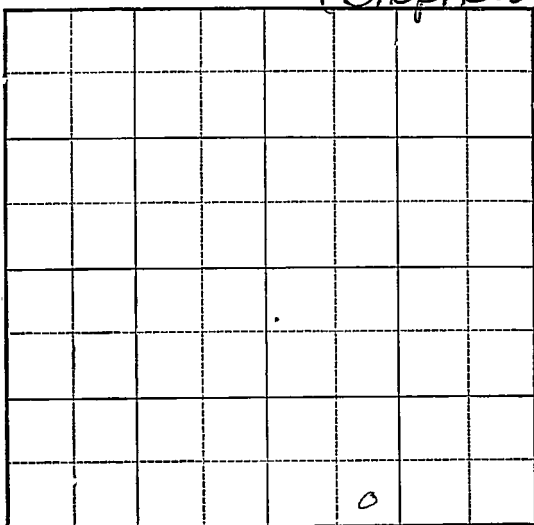

SOUTH

Location _____

Drilling Remarks

Rig Up _____

Drilling Remarks

RECORD

Cased _____ in. _____ ft.

Sand _____

Gas _____

Oil _____

Total Depth _____

PRODUCTION

1st 24 hrs. Nat. _____

1st 24 hrs. after shot _____

Gas _____ cu. ft.

Dry Hole _____

Abandoned _____

Greenwood

Map No. 17N Sec. 5 Twp. 22 R. 10Well No. 1 Shepherd FarmManhattan Oil and Gas Company

NORTH

Ft. from N. Line

330 Ft. from S. Line


Ft. from E. Line

990 Ft. from W. Line

WEST

EAST

SOUTH

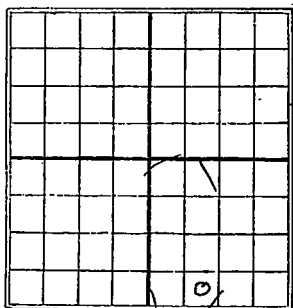

1926

Date

REPORT


7/28 R.O.G.
 8/4 Rig
 8/11 O.G. 490
 8/18 " 1375
 8/25 top sand 2062-2140'
 shot 260 gts, surf.
 & C.O., Est 400 bbls.
 9/1 Sand 2062-2140
 260/400 bbls.
 J.D. 2140

folger newood
 K21 KANSAS Sec. *7* Twp. *22* R. *10*
 Map No. _____
 Well No. *11* *Shepherd*
Manhattan Oil Co. et al. Company
 _____ Contractor

FIRST REPORTS

_____ Ft. from N. Line
330 _____ Ft. from S. Line
 _____ Ft. from E. Line
990 _____ Ft. from W. Line

SECTION PLAT

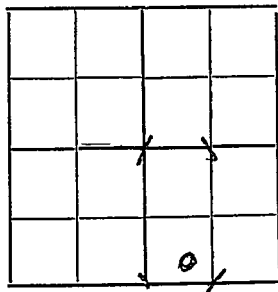

Location _____
 Rig up _____
 Drilling and Remarks:

Roby

RECORD

Cased _____ in., _____ ft.
 Sand _____
 Gas _____
 Oil _____
 Total Depth _____

PRODUCTION

1st 24 hrs. Nat. _____
 1st 24 hrs. after shot _____
 Gas _____ Cu. Ft.
 Dry Hole _____
 Abandoned _____

Date

JUL 28 1926

CHAS. L. SHERWOOD

192

Scout

21 KANSAS 2 Twp. 22 R. 10
Map No. Sec. Twp. R.

Well No. 1 Shepard
Manhattan and et al Company

Contractor

COMPLETED

SECTION PLAT

330 Ft. from N. Line
Ft. from S. Line
990 Ft. from E. Line
Ft. from W. Line

Location

Rig up

Drilling and Remarks:

260 400 ft.

RECORD

Cased in, ft.
Sand 2062-2140
Gas
Oil
Total Depth 2140

PRODUCTION

1st 24 hrs. Nat.
1st 24 hrs. after shot
Gas Cu. Ft.
Dry Hole
Abandoned

Date

SEP 1 1926

192

CHAS. L. SHERWOOD

Scout