

*Greenwood* ✓

Map No. *MAN* Sec. *2* Twp. *22* R. *10*

Well No. *2* *Shepherd* Farm

*Manhattan Oil & Gas* Company


NORTH

*(Shepherd)*

*15*

WEST

EAST

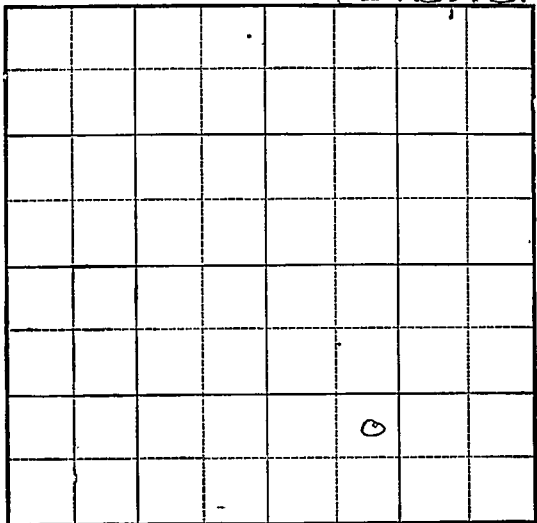

SOUTH

Location \_\_\_\_\_

Drilling Remarks

\_\_\_\_\_  
 \_\_\_\_\_  
Rig Up \_\_\_\_\_

Drilling Remarks

\_\_\_\_\_  
 \_\_\_\_\_  
RECORD

Cased \_\_\_\_\_ in. \_\_\_\_\_ ft.  
 Sand \_\_\_\_\_  
 Gas \_\_\_\_\_  
 Oil \_\_\_\_\_  
 Total Depth \_\_\_\_\_

PRODUCTION

1st 24 hrs. Nat. \_\_\_\_\_  
 1st 24 hrs. after shot \_\_\_\_\_  
 Gas \_\_\_\_\_ cu. ft.  
 Dry Hole \_\_\_\_\_  
 Abandoned \_\_\_\_\_


Map No. \_\_\_\_\_ Sec. 2 Twp. 22 R. 10Well No. 2 Shepherd FarmManhattan Oil & Gas Company

NORTH

\_\_\_\_\_ Ft. from N. Line

990 Ft. from S. Line

\_\_\_\_\_ Ft. from E. Line

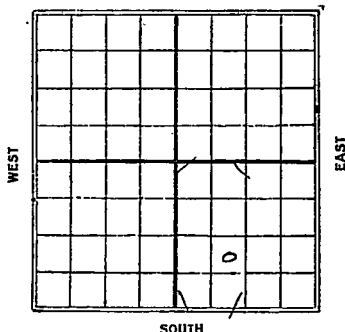990 Ft. from W. Line

SOUTH

1926

Date

REPORT

8/25 Location  
 8/31 Ripping up  
 9/16 Drilg 1085  
 9/22 " 1785  
 9/29 Top sand 2046' Drilg  
 10/6 Sand 2063-2120  
 Payed 2075-2120  
 P.B. to 2120  
 160/150 bbls

*Sherwood*  
 21 KANSAS Sec. 2 Twp. 22 R. 10  
 Map No. \_\_\_\_\_  
 Well No. 2 *Shepherd*  
*Manhattan Oil Co. et al* Company

Contractor \_\_\_\_\_

## FIRST REPORTS


## SECTION PLAT

\_\_\_\_\_ Ft. from N. Line

990 \_\_\_\_\_ Ft. from S. Line

\_\_\_\_\_ Ft. from E. Line

990 \_\_\_\_\_ Ft. from W. Line

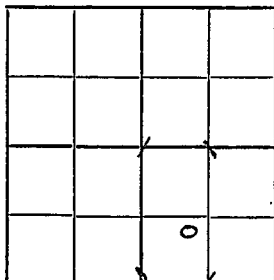Location ☒ \_\_\_\_\_

Rig up \_\_\_\_\_

Drilling and Remarks:

## RECORD

Cased \_\_\_\_\_ in., \_\_\_\_\_ ft.

Sand \_\_\_\_\_

Gas \_\_\_\_\_

Oil \_\_\_\_\_

Total Depth \_\_\_\_\_

## PRODUCTION

1st 24 hrs. Nat. \_\_\_\_\_

1st 24 hrs. after shot. \_\_\_\_\_

Gas \_\_\_\_\_ Cu. Ft.

Dry Hole \_\_\_\_\_

Abandoned \_\_\_\_\_

Date

AUG 25 1926

CHAS. L. SHERWOOD


192

Scout

*Colerwood*

21 KANSAS 2 22 10  
 Map No. Sec. Twp. R.  
 Well No. 2 Shepherd Farm  
*Manhattan Oil Co. et al* Company

990  
X  
990

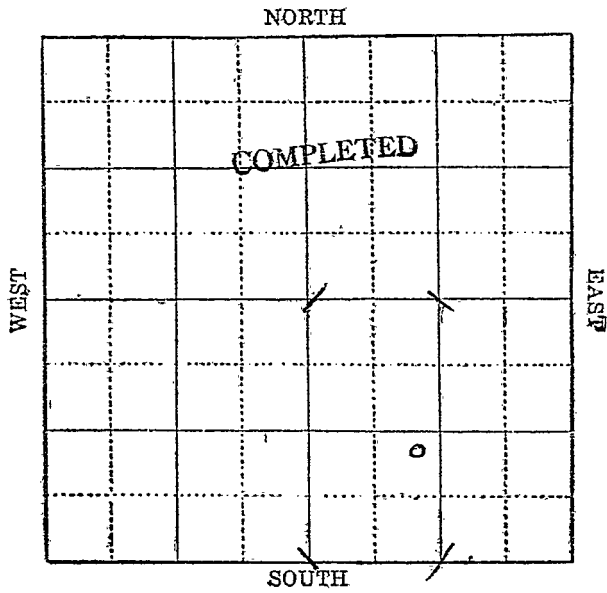

Location \_\_\_\_\_

Rig up \_\_\_\_\_

Drilling and Remarks:

*Play sd 2075-2120*

*P.B. to 2120*

*16 in 150 lbs.*

**RECORD**

Cased 1 in.,        ft.  
 Sand 2063-2120  
 Gas \_\_\_\_\_  
 Oil \_\_\_\_\_  
 Total Depth 2142'

**PRODUCTION**

1st 24 hrs. Nat. \_\_\_\_\_  
 1st 24 hrs. after shot \_\_\_\_\_  
 Gas \_\_\_\_\_ Cu. Ft.  
 Dry Hole \_\_\_\_\_  
 Abandoned \_\_\_\_\_

Date OCT 6 1926

**CHAS. L. SHERWOOD**

Scout