


Map No. _____ Sec. 2 Twp. 22 R. 10

Well No. 4 - Shepherd Farm _____
Manhattan oil Company

NORTH

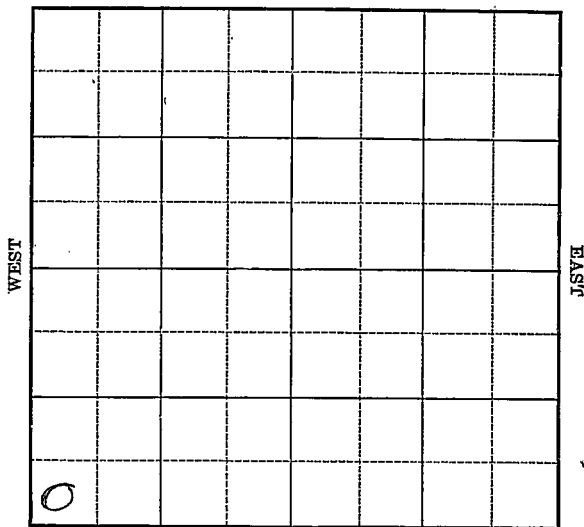

13

Location _____

Drilling Remarks _____

RECORD

Cased _____ in. _____ ft.

Sand _____

Gas _____

Oil _____

Total Depth _____

Rig Up _____

Drilling Remarks _____

PRODUCTION

1st 24 hrs. Nat. _____

1st 24 hrs. after shot _____

Gas _____ cu. ft.

Dry Hole _____

Abandoned _____

Map No. 5 Sec. 2 Twp. 22 R. 10

Well No. 4 - Shepherd Farm
Manhattan oil Company


_____ Ft. from N. Line .

330 Ft. from S. Line

_____ Ft. from E. Line

330 Ft. from W. Line

1927

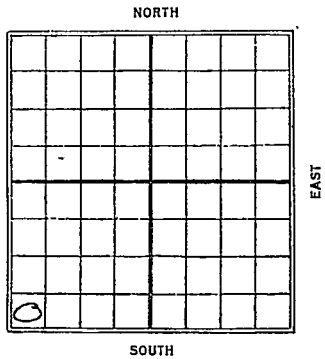

Date

REPORT

9/28 Spudding

10/6 Drly 450'

10/12 " 1625'

10/19 2067-2128
100/200 bbl
T.D. 2142

21 KANSAS Map No. Sec. 2 Twp. 22 R. 10

Well No. 4 Shephers Manhattan Oil Co Company

Contractor

FIRST REPORTS

Ft. from N. Line 330
Ft. from S. Line
Ft. from E. Line
Ft. from W. Line 330

SECTION PLAT


Location
Rig up
Drilling and Remarks:


RECORD

Cased in., ft.
Sand
Gas
Oil
Total Depth

PRODUCTION

1st 24 hrs. Nat.
1st 24 hrs. after shot
Gas Cu. Ft.
Dry Hole
Abandoned

Date SEP 28 1927

CHAS. L. SHERWOOD Scout

Sherwood

21 KANSAS Map No. Sec. 2 Twp. 22 R. 10

Well No. 4 Stephens
Manhattan Oil Co Company

Contractor

COMPLETED

SECTION PLAT

_____ Ft. from N. Line
330 Ft. from S. Line
_____ Ft. from E. Line
330 Ft. from W. Line

0			

Location _____

Rig up _____

Drilling and Remarks:

100 / 200 Bl.

RECORD

Cased _____ in., _____ ft.
Sand 2067-2128
Gas _____
Oil _____
Total Depth 2142

PRODUCTION

1st 24 hrs. Nat. _____
1st 24 hrs. after shot _____
Gas _____ Cu. Ft.
Dry Hole _____
Abandoned _____

Date

OCT 19 1927

CHAS. L. SHERWOOD Scout