

Coffey

KANSAS

SECTION 2 TOWNSHIP 22 RANGE 13E

WELL NO. #2 Hatch

COMPANY Rex & Morris

NORTH

				0			

WEST

EAST

SOUTH

SEC. 2	TWP. 22	R. ## 13E
-----------	------------	-------------------------

WELL NO. #2 Hatch FARM

COMPANY
Rex & Morris

CONTRACTOR
Tom Kilby

Hatch


_____ Ft. from N. Line

_____ Ft. from S. Line

_____ Ft. from E. Line

_____ Ft. from W. Line

NW NW NE

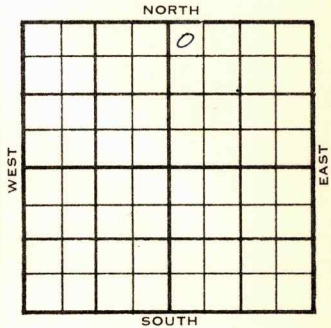

	ELEVATION	REPORT
--	-----------	--------

1956

5-2 Comm. 4-26-56
Drlg. 360

5-23 ~~5~~ 6" @ 1700
10" @ 670
8 5/8" @ 1300'
D&A
KC. 605', BKC 1150', Burg 1798',
M. 1807',
TD 1849'

ABANDONED

County Coffey Elev. _____
 Sec. 2 Twp. 22 Rgs. 13E
 Company Rex & Morris
 Farm Name Hatch No. 2

TOPS	DEPTH	LOG	DATUM
Anh.			
Tp.			
H.			
Tr.			
Dg.			
Bl.			
L.			
K.C.			
B.K.C.			
Ce.			
C.			
M.			
M.			
K.			
Mz.			
Mo.			
V.			
S.			
S.			
A.			
R.			
Pe.			
G.			
T.D.			

Loc. in Sec. NW NW NE
 Geol. _____
 Contr. Tom Kilby
 Pool Hatch

0
 FIRST REPORT
 MAY 2 1956

Date Comm. 4-26-56
 drlg. 360

MAY 7 1956

R.G.

Co.
 Lse.
 No.
 Sec.
 T.
 R.

County Coffey Elev. _____
 Sec. 2 Twp. 22 Rge. 13E
 Company Rex & Morris
 Farm Name Hatch No. 2

TOPS	DEPTH	LOG	DATUM
Anh.			
Tr.			
H.			
Tr.			
Dg.			
Bl.			
L.			
K.C.	<u>685</u>		
B.K.C.	<u>1150</u>		
Gr. <u>Burg</u>	<u>1798</u>		
C.			
M.	<u>1807</u>		
M.			
K.			
Mz.			
Ma.			
V.			
S.			
S.			
A.			
R.			
PE.			
G.			
T.D.	<u>1849</u>		

Loc. in Sec. NW NW NE
 Geol. _____
 Contr. Tom Kilby
 Pool Hatch

ABANDONED

Date Comm. 4-26-56 MAY 23 1956

drlg. 360 MAY 9 '56 990 MAY 16 '56
688 @ 1700 MAY 23 '56 10" @ 670
858 @ 1300

DEA

Co. No. Sec. T. R.