

Coffey

KANSAS


FORM 51 25M 3-49 PETROL



Section 2 Township 22 Range 13E

Well No. #2 Povenmeir

Company Aikman & Braden

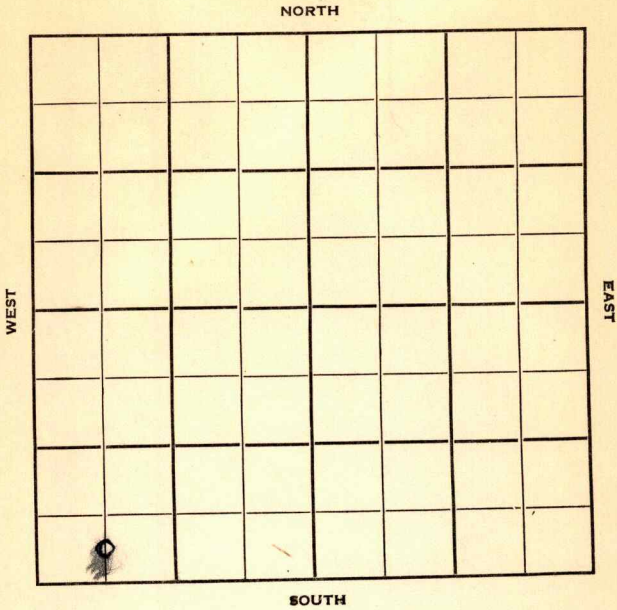

KANSAS

Coffey ✓

Sec. 2 Twp. 22 R. 13-E

Well No. #2 Povenmeir Farm

Akman & Braden Company

Contractor


Ft. from N. Line

330 Ft. from S. Line

Ft. from E. Line

660 Ft. from W. Line

S/2 SW SW

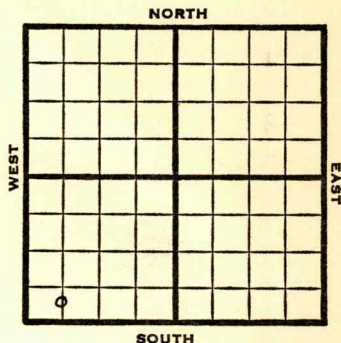

1950

Elev. - REPORT

6/7

8" @ 34
Drlg 400

6/21

8" @ 34'
5" @ 1795
Miss Chat 1840-45
Miss Lime 1845-65
TD 1865'
D&A

ABANDONED

Kansas

Map No. _____ Sec. 2 Twp. 22 R. 13EWell No. 2 Povenmeir

_____ Aikman & Braden _____ Company

_____ Contractor

C S L SW SW

SECTION PLAT

_____ Ft. from N. Line

330 Ft. from S. Line

_____ Ft. from E. Line

660 Ft. from W. Line

Coffey County

Location _____

Rig up _____

Drilling and Remarks:

8" @ 34

5" @ 1795

Miss. chat 1840-45 1st 24 hrs. Nat. _____

Miss. lime 1845-65 1st 24 hrs. after shot _____

TD 1865

D & A

RECORD

Cased _____ in., _____ ft.

Sand _____

Gas _____

Oil _____

Total Depth 1865

PRODUCTION

1st 24 hrs. Nat. _____

1st 24 hrs. after shot _____

Gas _____ Cu. Ft.

Dry Hole _____

Abandoned _____

Date

JUN 21 1950 19J. E. TYRA Scout