

Company

WEST

EAST

SOUTH

Drilling Remarks

Drilling Remarks

PRODUCTION

1st 24 hrs. Nat._____

1st 24 hrs. after shot_____

Gas -----cu. ft.-----

Dry Hole

Abandoned_____

Coffey

Map No. **KANSAS** Sec. 2 Twp. 22 R. 13E

Well No. 1 *Gold* Farm


Aikman & Baker. Company

990 Ft. from N. Line

_____ Ft. from S. Line

330 Ft. from E. Line

_____ Ft. from W. Line

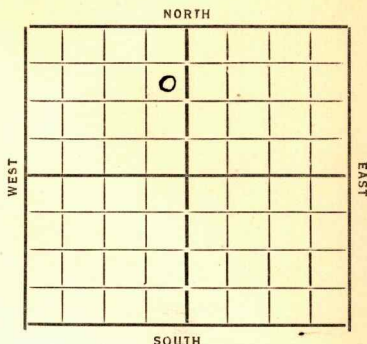

Date 1934

REPORT

2/21 *Spud.*
3/1 *SD 800*
3/8 _____
3/15 *Only 1600*
3/22 _____
3/28 *Sand 1789-1830 95 shot*
10 qts 8 Bbls.

COMPLETED

Map No. 20 Sec. 2 Twp. 22 R. 13E

Well No. 1-Todd

Cikman & Baker Company

Contractor

COMPLETED

SECTION PLAT

990 Ft. from N. Line

..... Ft. from S. Line

330 Ft. from E. Line

..... Ft. from W. Line

Location.....

Rig up.....

Drilling and Remarks:

shot 10 gts

8 bbls

RECORD

Cased.....in.,.....ft.

Sand 1789-1830

Gas.....

Oil.....

Total Depth 1830

PRODUCTION

1st 24 hrs. Nat.....

1st 24 hrs. after shot.....

Gas.....Cu. Ft.

Dry Hole.....

Abandoned.....

Date

3/28/34 192 O. Mammeehead Scout

Map No. 20 Sec. 2 Twp. 22 R. 13E

Well No. 1- Todd
Aikman + Baker Company

Contractor

FIRST REPORT

SECTION PLAT

990 Ft. from N. Line

_____ Ft. from S. Line

330 Ft. from E. Line

_____ Ft. from W. Line

	0		

Location _____

Rig up _____

Drilling and Remarks:

RECORD

Cased _____ in., _____ ft.

Sand _____

Gas _____

Oil _____

Total Depth _____

PRODUCTION

1st 24 hrs. Nat. _____

1st 24 hrs. after shot _____

Gas _____ Cu. Ft.

Dry Hole _____

Abandoned _____

Date

2-21-34 192

O. Mannschreck Scout