
Form 51 5M 11-23 13896

Map No. 9 Sec. 20 Twp. 22 R. 10 ✓

Well No. 6 Browning Farm

Sinclair Company

NORTH

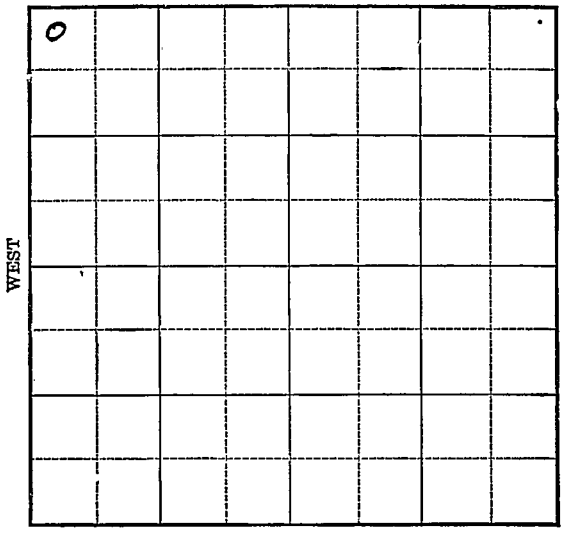

SOUTH

4

Location _____

Drilling Remarks:

Rig Up _____

Drilling Remarks:

RECORD

Cased _____ in. _____ ft.

Sand _____

Gas _____

Oil _____

Total Depth _____

PRODUCTION

1st 24 hrs. Nat. _____

1st 24 hrs. after shot _____

Gas _____ cu. ft.

Dry Hole _____

Abandoned _____

Form 252A 5M 2-24 15129

Map No. K Sec. 20 Twp. 22 R. 10

Well No. 1 - Browning Farm


Sinclair Company

200 Ft. from N. Line

_____ Ft. from S. Line

_____ Ft. from E. Line

200 Ft. from W. Line

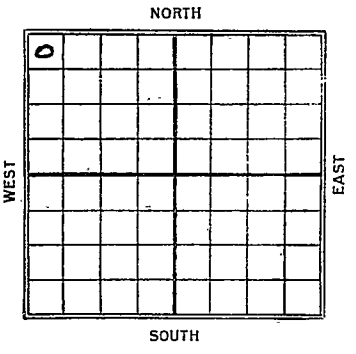

Date	REPORT
1/24	
4/21	Location
1/24	Rig
7/9	Tup 2301 - 35 · 72
	& 5 Bbls Nat.

Form 26—1M Bks.—3-23—11959.

Map No. KANSAS 21 Sec. 20 Twp. 22 R. 10

Well No. #1 Browning

Sinclair Company

Contractor

FIRST REPORT


200 Ft. from N. Line

Ft. from S. Line

Ft. from E. Line

200 Ft. from W. Line

SECTION PLAT

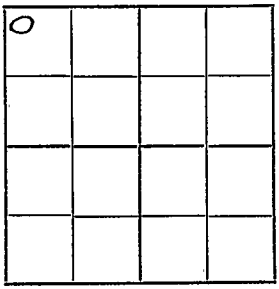

Location V V

Rig up

Drilling and Remarks:

RECORD

Cased in., ft.

Sand

Gas

Oil

Total Depth

PRODUCTION

1st 24 hrs. Nat.

1st 24 hrs. after shot

Gas Cu. Ft.

Dry Hole

Abandoned

Date APR 21 1924

192

M. A. BENEAR

Scout

Form 26—1M Bks.—3-23—11959.

Map No. 21 KANSAS Sec. 20 Twp. 22 R. 10


Well No. 1 Browning

Sun Dale Oil Co. Company

Contractor

COMPLETED

SECTION PLAT

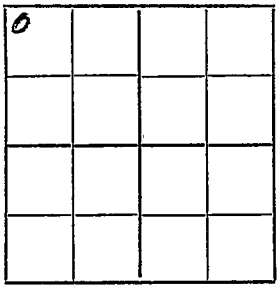

200 Ft. from N. Line

Ft. from S. Line

Ft. from E. Line

200 Ft. from W. Line

COMPLETED

Location

Rig up

Drilling and Remarks:

Tap 2301-35

D5 Hbmah

RECORD

Cased in., ft.

Sand

Gas

Oil

Total Depth

PRODUCTION

1st 24 hrs. Nat.

1st 24 hrs. after shot

Gas Cu. Ft.

Dry Hole

Abandoned

Date

JUL 9 1924

192

M. A. BENEAR

Scout