


Map No. Kansas Sec. 20 Twp. 22 R. 10

Well No. 22 Browning Farm
Senclair O. & G. Company

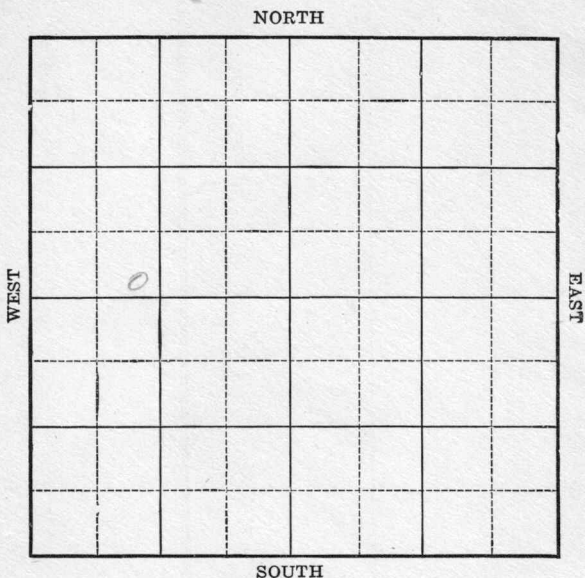

Location _____
Drilling Remarks _____

Rig Up _____
Drilling Remarks _____

RECORD

Cased _____ in. _____ ft.
Sand _____
Gas _____
Oil _____
Total Depth _____

PRODUCTION

1st 24 hrs. Nat. _____
1st. 24 hrs. after shot _____
Gas _____ cu. ft.
Dry Hole _____
Abandoned _____

Map No. *Kansas* Sec. *20* Twp. *22* R. *10*

Well No. *22 Browning* Farm


Sinclair O & G Company

..... Ft. from N. Line

330 Ft. from S. Line

..... Ft. from E. Line

990 Ft. from W. Line

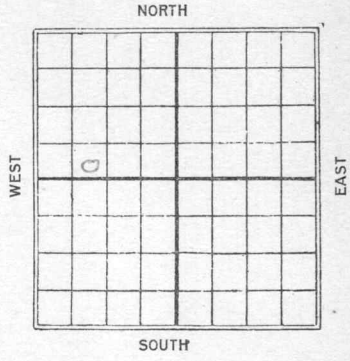

C.

Date	REPORT
<i>1925</i>	
<i>5/21</i>	<i>Bldg Rig</i>
<i>5/29</i>	<i>Bldg Rig</i>
<i>6/5</i>	<i>Rig</i>
<i>6/12</i>	<i>_____</i>
<i>6/19</i>	<i>Spud</i>
<i>6/26</i>	<i>750</i>
<i>7/3</i>	<i>1330</i>
<i>7/10</i>	<i>1770</i>
<i>7/17</i>	<i>2200</i>
<i>7/22</i>	<i>- S. 2276 - 2347'</i>
	<i>J.D. 2347</i>
	<i>30 / 300 bbls.</i>

Map No. 21 15knts Sec. 20 Twp. 22 R. 10

Well No. 22 Blowing

Linclair Oil & Gas Co. Company

Contractor

FIRST REPORTS

SECTION PLAT

_____ Ft. from N. Line

330

_____ Ft. from S. Line

_____ Ft. from E. Line

990

_____ Ft. from W. Line

Location _____

Rig up _____

Drilling and Remarks:

Blow by

RECORD

Cased _____ in., _____ ft.

Sand _____

Gas _____

Oil _____

Total Depth _____

PRODUCTION

1st 24 hrs. Nat. _____

1st 24 hrs. after shot _____

Gas _____ Cu. Ft.

Dry Hole _____

Abandoned _____

Date

MAY 21 1925

CHAS. L. SHERWOOD

Scout

Map No. 21 Lands Sec. 20 Twp. 22 R. 10

Well No. 22 Blowing

Linckie Oil & Gas Co. Company

Contractor

SECTION PLAT

_____ Ft. from N. Line

330 Ft. from S. Line

_____ Ft. from E. Line

990 Ft. from W. Line

Completed

RECORD

Location _____

Rig up _____

Drilling and Remarks:

301/300 bks

Cased _____ in., _____ ft.

Sand 2276-2347'

Gas _____

Oil _____

Total Depth 2347'

PRODUCTION

1st 24 hrs. Nat. _____

1st 24 hrs. after shot _____

Gas _____ Cu. Ft.

Dry Hole _____

Abandoned _____

Date

JUL 24 1925

CHAS. L. SHERWOOD