

Map No. Kan Sec. 20 Twp. 22 R. 10 ^{III}


Well No. 24 Browning Farm
Suiclain O & B Company

990' Ft. from N. Line

_____ Ft. from S. Line

_____ Ft. from E. Line

990' Ft. from W. Line

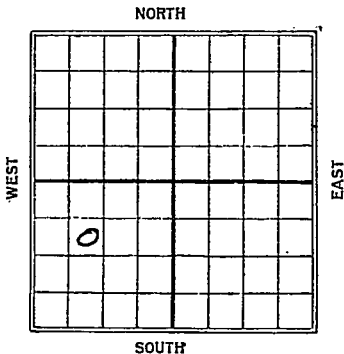

Date	REPORT
7/25	
7/24	Lod.
7/31	✓
8/7	—
8/14	—
8/19	—
8/26	—
9/3	—
9/11	Rign up.
9/16	Lodg 350
9/24	—
10/1	Daly 1550
10/8	D 2200
10/16	Sand 2253-2323 10 gals
	250 Bbls

Map No. Shado Sec. 20 Twp. 22 R. 10

Well No. 74 Browning

Anchor Oil & Gas Co Company

Contractor

FIRST REPORTS

SECTION PLAT

990 Ft. from N. Line
 _____ Ft. from S. Line
 _____ Ft. from E. Line
990 Ft. from W. Line

Location ✓
 Rig up _____
 Drilling and Remarks:

RECORD

Cased _____ in., _____ ft.
 Sand _____
 Gas _____
 Oil _____
 Total Depth _____

PRODUCTION

1st 24 hrs. Nat. _____
 1st 24 hrs. after shot _____
 Gas _____ Cu. Ft.
 Dry Hole _____
 Abandoned _____

Date
JUL 24 1925

CHAS. L. SHERWOOD

192 _____ Scout

Moorewood Co

K 271 KANSAS Map No. Sec. *20* Twp. *22* R. *10*

Well No. *Blowing*

Shelton oil & gas Company

Contractor

COMPLETED

SECTION PLAT

990 Ft. from N. Line

----- Ft. from S. Line

----- Ft. from E. Line

990 Ft. from W. Line

Location -----

Rig up -----

Drilling and Remarks:

107 250 bhs.

RECORD

Cased *2252-2323* in., *2323* ft.

Sand *2252-2323*

Gas -----

Oil -----

Total Depth *2323*

PRODUCTION

1st 24 hrs. Nat. -----

1st 24 hrs. after shot -----

Gas ----- Cu. Ft.

Dry Hole -----

Abandoned -----

Date
OCT 16 1925

192 CHAS. L. SHERWOOD
----- Scout