

Map No. Kansas Sec. 20 Twp. 22 R. 10
Well No. 25 Browning Farm
Sinclair O & G Company

Well No. 25 Browning Farm
Snclair O & G Company

WEST

EAST

SOUTH

14.

Drilling Remarks

Drilling Remarks

Cased _____ in. _____ ft.
 Sand _____
 Gas _____
 Oil _____
 Total Depth _____

1st 24 hrs. Nat. _____
1st. 24 hrs. after shot _____
Gas _____ cu. ft.
Dry Hole _____
Abandoned _____

Greenwood


Map No. 1 Kansas Sec. 20 Twp. 22 R. 10Well No. 25 Browning Farm
Shelair O. & G. Company

Ft. from N. Line

330 Ft. from S. Line

Ft. from E. Line

1320 Ft. from W. Line

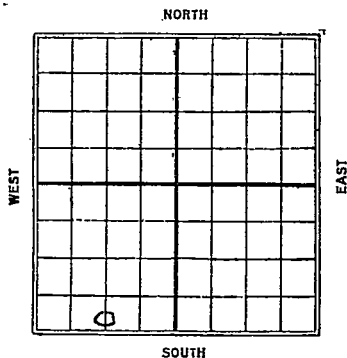Date 7/25

REPORT

8/20 Sly 4008/26 1360'9/3 1895'9/11 Top sand 2275-2346hole full of oil9/19 Sand 2275-2346100 gts 500 Bbls

Johnwood Co
 Map No. 21 KANSAS Sec. 20 Twp. 22 R. 10
 Well No. 25 *Blowing*
Linclair oil & Gas Co Company

Contractor

FIRST REPORTS

SECTION PLAT

Ft. from N. Line

330

Ft. from S. Line

Ft. from E. Line

1320

Ft. from W. Line

Location

Rig up

Drilling and Remarks:

Only 400'

RECORD

Cased _____ in., _____ ft.

Sand _____

Gas _____

Oil _____

Total Depth _____

PRODUCTION

1st 24 hrs. Nat. _____

1st 24 hrs. after shot _____

Gas _____ Cu. Ft.

Dry Hole _____

Abandoned _____

Date

AUG 20 1925

CHAS. L. SHERWOOD

192


Scout

Moenwaad Co
 Map No. KANSAS Sec. 20 Twp. 22 R. 10
 Well No. 75 Downing
Amclair oil & gas Co Company

Contractor

COMPLETED

SECTION PLAT

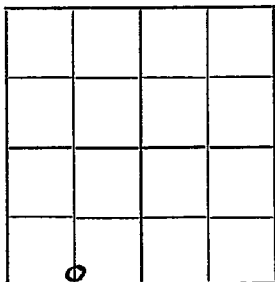

Ft. from N. Line

330

Ft. from S. Line

Ft. from E. Line

1320

Ft. from W. Line

Location

Rig up

Drilling and Remarks:

RECORD

Cased in, ft.

Sand 2275-2346

Gas

Oil

Total Depth 2346

PRODUCTION

1st 24 hrs. Nat.

1st 24 hrs. after shot

Gas Cu. Ft.

Dry Hole

Abandoned

Date

SEP 19 1925

CHAS. L. SHERWOOD

192

Scout