

Map No. Canon Sec. 20 Twp. 22 R. 10
Well No. 29 Browning Farm
Sanclair O & G Company

NORTH

WEST

FAST

SOUTH

Location _____

Drilling Remarks

Rig Up_____

Drilling Remarks

RECORD

Cased_____in. _____ft.

Sand

Gas

Oil

Total Depth _____

PRODUCTION

1st 24 hrs. Nat. _____

1st 24 hrs. after shot _____

Gas_____cu. ft.

Dry Hole_____

Abandoned -----


Map No. KANSAS Sec. 20 Twp. 22 R. 10
 Well No. 29 Browning Farm
Linclair O & G. Company

990' Ft. from N. Line

_____ Ft. from S. Line

990' Ft. from E. Line

_____ Ft. from W. Line

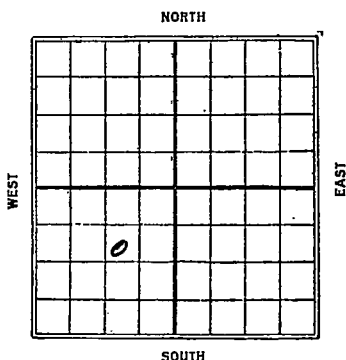

1925

Date REPORT

10/16	Location
10/22	Bldg Rig.
10/29	Rig
11/6	spudding
11/12	475'
11/19	1200'
11-27	Drly 1635'
12/3	✓ 2240'
12/10	Top Band 2272-2340 2.0. m. Band Filler up 1800' oil natural. 24 Swabbing & Churning out.
12/17	Land 2272-2340 30 gts 200 Bbls

Sherwood Co

K21 Map No. KANSAS Sec. 20 Twp. 22 R. 10

Well No. 29 Browning
Sinker oil & gas Company

Contractor

FIRST REPORTS

SECTION PLAT

990 Ft. from N. Line

Ft. from S. Line

990 Ft. from E. Line

Ft. from W. Line

Location ✓

Rig up

Drilling and Remarks:

RECORD

Cased in., ft.

Sand

Gas

Oil

Total Depth

PRODUCTION

1st 24 hrs. Nat.

1st 24 hrs. after shot

Gas Cu. Ft.

Dry Hole

Abandoned

Date

OCT 16 1925

192

CHAS. L. SHERWOOD
Scout

Map No. KANSAS 21 Sec. 20 Twp. 22 R. 10
 Well No. 29 PLOWING
Anchor Oil & Gas Co Company

Contractor

COMPLETED

SECTION PLAT

990 Ft. from N. Line

Ft. from S. Line

990 Ft. from E. Line

Ft. from W. Line

Location

Rig up

Drilling and Remarks:

RECORD

Cased _____ in. _____ ft.

Sand 2272-2340'

Gas _____

Oil _____

Total Depth 2340'

PRODUCTION

1st 24 hrs. Nat. _____

1st 24 hrs. after shot _____

Gas _____ Cu. Ft.

Dry Hole _____

Abandoned _____

Date

30/200 bhs
DEC 17 1925 CHAS. L. SHERWOOD
192 Scout