


Map No. Kan Sec. 20 Twp. 22 R. 10

Well No. 45 Browning Farm

Sinclair O & G. Company

NORTH

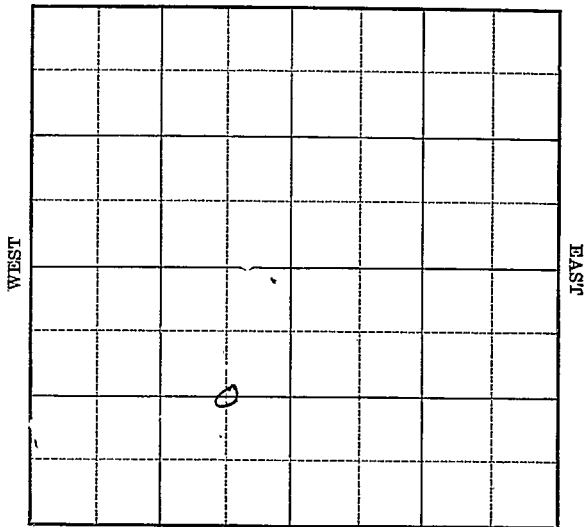

SOUTH

Location \_\_\_\_\_

Drilling Remarks \_\_\_\_\_  
\_\_\_\_\_  
\_\_\_\_\_  
Rig Up \_\_\_\_\_

Drilling Remarks \_\_\_\_\_  
\_\_\_\_\_  
\_\_\_\_\_  
**RECORD**

Cased \_\_\_\_\_ in. \_\_\_\_\_ ft.

Sand \_\_\_\_\_

Gas \_\_\_\_\_

Oil \_\_\_\_\_

Total Depth \_\_\_\_\_

**PRODUCTION**

1st 24 hrs. Nat. \_\_\_\_\_

1st 24 hrs. after shot \_\_\_\_\_

Gas \_\_\_\_\_ cu. ft.

Dry Hole \_\_\_\_\_

Abandoned \_\_\_\_\_



*Steenward*

Map No. K21 KANSAS Sec. 20 Twp. 22 R. 10

Well No. 45 *Browning*  
*Sinclair Oil Co* Company

Contractor

FIRST REPORTS

SECTION PLAT

\_\_\_\_\_ Ft. from N. Line  
1320 Ft. from S. Line  
660 Ft. from E. Line  
\_\_\_\_\_ Ft. from W. Line


Location  \_\_\_\_\_  
Rig up \_\_\_\_\_  
Drilling and Remarks:

RECORD

Cased \_\_\_\_\_ in., \_\_\_\_\_ ft.  
Sand \_\_\_\_\_  
Gas \_\_\_\_\_  
Oil \_\_\_\_\_  
Total Depth \_\_\_\_\_

PRODUCTION

1st 24 hrs. Nat. \_\_\_\_\_  
1st 24 hrs. after shot \_\_\_\_\_  
Gas \_\_\_\_\_ Cu. Ft.  
Dry Hole \_\_\_\_\_  
Abandoned \_\_\_\_\_

Date  
JUN 24 1926

CHAS. L. SHERWOOD

192 Scout

*Greenwood*

KANSAS

Map No. *21* Sec. *20* Twp. *22* R. *10*

Well No. *45 Browning*

*Beclair O & S*

Company

Contractor

COMPLETED

SECTION PLAT

\_\_\_\_\_ Ft. from N. Line

*1320* Ft. from S. Line

*660* Ft. from E. Line

\_\_\_\_\_ Ft. from W. Line

	e		

Location \_\_\_\_\_

Rig up \_\_\_\_\_

Drilling and Remarks:

*69125 ff.*

RECORD

Cased \_\_\_\_\_ in., \_\_\_\_\_ ft.

Sand *2266-2337*

Gas \_\_\_\_\_

Oil \_\_\_\_\_

Total Depth *2337*

PRODUCTION

1st 24 hrs. Nat. \_\_\_\_\_

1st 24 hrs. after shot \_\_\_\_\_

Gas \_\_\_\_\_ Cu. Ft.

Dry Hole \_\_\_\_\_

Abandoned \_\_\_\_\_

Date

SEP 15 1926

CHAS. L. SHERWOOD

Scout