


Greenwood ✓

Map No. Ks Sec. 20 Twp. 22 R. 10Well No. 50 Browning Farm  
Sinclair Oil & Gas Company

NORTH

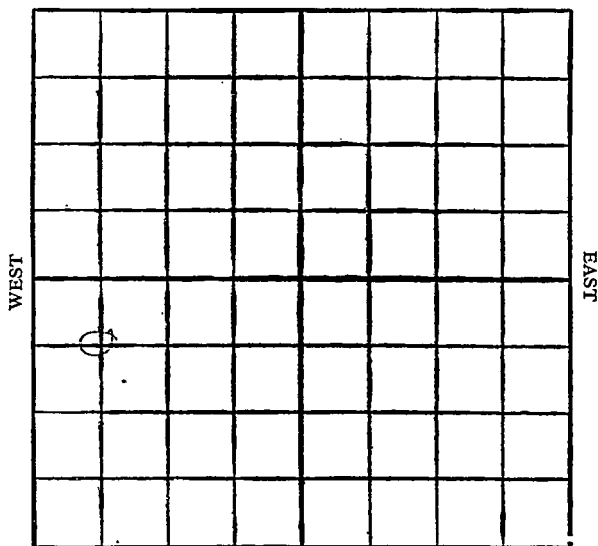

SOUTH

12

Location .....

Drilling Remarks

Rig Up .....

Drilling Remarks

## RECORD

Cased ..... in. .... ft.

Sand .....

Gas .....

Oil .....

Total Depth .....

## PRODUCTION

1st 24 hrs. Nat. ....

1st 24 hrs. after shot .....

Gas ..... cu. ft.


Dry Hole .....

Abandoned .....

Map No. 10 Sec. 20 Twp. 22 R. 10Well No. 50 Browning FarmSinclair O. & G. Company660 Ft. from N. Line

\_\_\_\_\_ Ft. from S. Line

\_\_\_\_\_ Ft. from E. Line

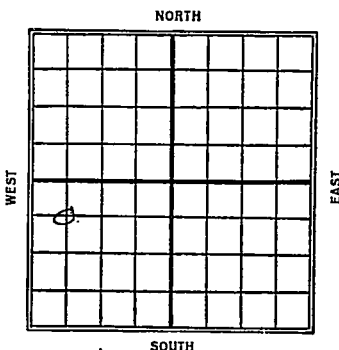660 Ft. from W. Line1926

Date

REPORT

|              |                                 |
|--------------|---------------------------------|
| <u>11/11</u> | <u>Rig up</u>                   |
| <u>11/17</u> | <u>✓</u>                        |
| <u>11/23</u> | <u>Same</u>                     |
| <u>12/8</u>  | <u>—</u>                        |
| <u>12/15</u> | <u>Rigging up</u>               |
| <u>12/22</u> | <u>Spudding</u>                 |
| <u>12/30</u> | <u>Drlg 425</u>                 |
| <u>1927</u>  |                                 |
| <u>1/6</u>   | <u>Drlg 1410</u>                |
| <u>1/13</u>  | <u>" 1940</u>                   |
| <u>1/19</u>  | <u>Land 2250-2318 T.D. 2320</u> |
|              | <u>60 gts 125 bbls</u>          |

21 KANSAS 20 22 10  
 Map No. Sec. Twp. R.  
 Well No. 50 Browning  
 Sinclair Oil Co. Company

Contractor

## SECTION PLAT

660 Ft. from N. Line

Ft. from S. Line

Ft. from E. Line

660 Ft. from W. Line

FIRST REPORTS

|   |  |  |  |
|---|--|--|--|
|   |  |  |  |
|   |  |  |  |
| 0 |  |  |  |
|   |  |  |  |

Location

Rig up ✓

Drilling and Remarks:

## RECORD

Cased in, ft.

Sand

Gas

Oil

Total Depth

## PRODUCTION

1st 24 hrs. Nat.

1st 24 hrs. after shot

Gas Cu. Ft.

Dry Hole

Abandoned

Date

NOV 11 1926

192

CHAS. L. SHERWOOD

Scout

21 KANSAS Sec. 20 Twp. 22 R. 10 E

Well No. 50 Browning  
 Sinclair Oil Co. Company

Contractor

COMPLETED

SECTION PLAT

660 Ft. from N. Line

\_\_\_\_\_ Ft. from S. Line

\_\_\_\_\_ Ft. from E. Line

660 Ft. from W. Line

|   |  |  |  |
|---|--|--|--|
|   |  |  |  |
|   |  |  |  |
| 0 |  |  |  |
|   |  |  |  |

Location \_\_\_\_\_

Rig up \_\_\_\_\_

Drilling and Remarks:

64 125 Bl.

RECORD

Cased \_\_\_\_\_ in., \_\_\_\_\_ ft.

Sand 2250-2318

Gas \_\_\_\_\_

Oil \_\_\_\_\_

Total Depth 2320

PRODUCTION

1st 24 hrs. Nat. \_\_\_\_\_

1st 24 hrs. after shot \_\_\_\_\_

Gas \_\_\_\_\_ Cu. Ft.

Dry Hole \_\_\_\_\_

Abandoned \_\_\_\_\_

Date

JAN 19 1927

CHAS. L. SHERWOOD

192

Scout