


Greenwood

Map No. *15* Sec. *20* Twp. *22* R. *10*

Well No. *51 - Browning* Farm
Sindair O. & G. Company

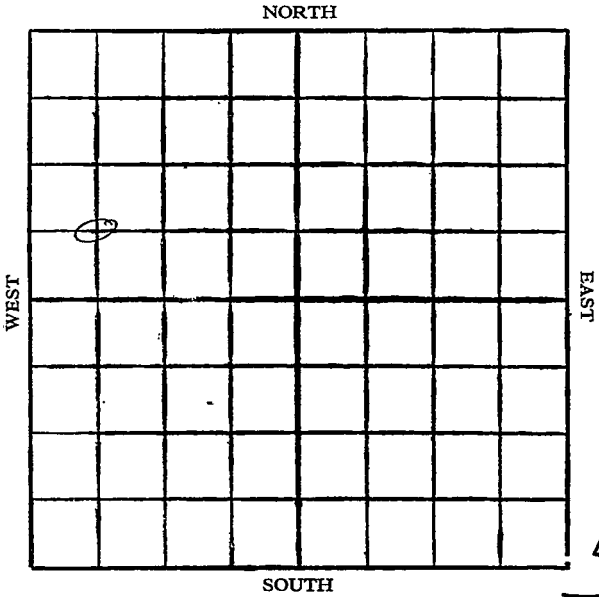

Location

Rig Up

Drilling Remarks

Drilling Remarks

.....

.....

RECORD

PRODUCTION

Cased..... in. ft.

Sand

Gas

Oil

Total Depth.....

1st 24 hrs. Nat.....

1st 24 hrs. after shot.....

Gas..... cu. ft.

Dry Hole.....

Abandoned.....

Map No. Ks Sec. 20 Twp. 22 R. 10


Well No. 51- Browning Farm
Sinclair Oil + Gas Company

_____ Ft. from N. Line

660 Ft. from S. Line

_____ Ft. from E. Line

660 Ft. from W. Line

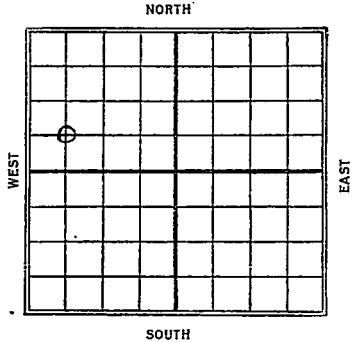

| Date | REPORT |
|--------------|-----------------------|
| <u>1926</u> | |
| <u>12/8</u> | <u>Rig up</u> |
| <u>12/15</u> | <u>same</u> |
| <u>12/22</u> | <u>spudding</u> |
| <u>12/30</u> | <u>Drlg 1125</u> |
| <u>1927</u> | |
| <u>1/6</u> | <u>Drlg 1230</u> |
| <u>1/13</u> | <u>" 1800</u> |
| <u>1/19</u> | <u>" 2275</u> |
| <u>1/26</u> | <u>same</u> |
| <u>2/3</u> | <u>sand 2283-2344</u> |
| | <u>60/150 bbls</u> |
| | <u>J.D: 2344</u> |

Greenwood

21 KANSAS
 Map No. _____ Sec. *20* Twp. *22* R. *10*

Well No. *51 Browning*

Sinclair Oil & Gas Co. Company

 Contractor

FIRST REPORTS

SECTION PLAT

_____ Ft. from N. Line

660 Ft. from S. Line

_____ Ft. from E. Line

660 Ft. from W. Line

| | | | |
|---|--|--|--|
| | | | |
| o | | | |
| | | | |
| | | | |

Location _____

Rig up

Drilling and Remarks:

RECORD

Cased _____ in., _____ ft.

Sand _____

Gas _____

Oil _____

Total Depth _____

PRODUCTION

1st 24 hrs. Nat. _____

1st 24 hrs. after shot _____

Gas _____ Cu. Ft.

Dry Hole _____

Abandoned _____

Date
 DEC 8 1926

CHAS. L. SHERWOOD

192 _____ Scout

Sherwood

Map No. 21 KANSAS Sec. 20 Twp. 22 R. 10

Well No. 51 Browning
Sinclair Company

Contractor

COMPLETED

SECTION PLAT

_____ Ft. from N. Line

660 Ft. from S. Line

_____ Ft. from E. Line

660 Ft. from W. Line

| | | | |
|---|--|--|--|
| | | | |
| 0 | | | |
| | | | |
| | | | |

Location _____

Rig up _____

Drilling and Remarks:

64 150 Bl.

RECORD

Cased _____ in., _____ ft.

Sand 2283-2344

Gas _____

Oil _____

Total Depth 2344

PRODUCTION

1st 24 hrs. Nat. _____

1st 24 hrs. after shot. _____

Gas _____ Cu. Ft.

Dry Hole _____

Abandoned _____

Date

DEC 3 1927

CHAS. L. SHERWOOD

Scout