

Greenwood

KANSAS

Form 51-5M-11-38-Palace


Section 20 Township 22 Range 10-E

Well No. 57 Browning

Company Sinclair

Browning Pool

NORTH

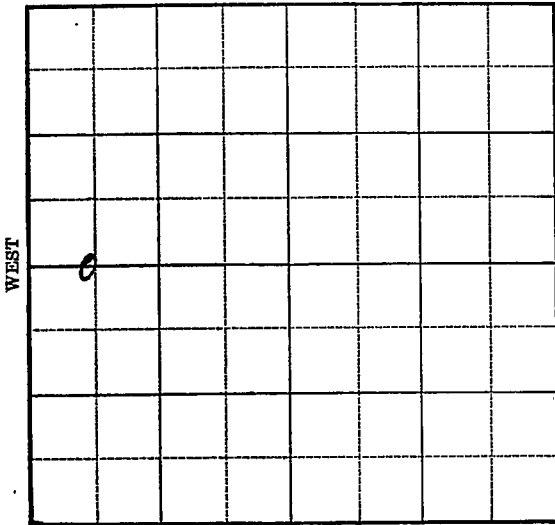

SOUTH

5



1939  
6/14

Bart. 2260'  
Shot 20 qts. 2257-63'  
T.D. 2363'  
Pump 25 bbis.

COMPLETED

Map No. 21 Sec. 20 Twp. 22 R. 10E

Well No. 57 Browning

Sinclair Prairie Company

Contractor

**FIRST REPORT**

C  $W\frac{1}{2}$   $W\frac{1}{2}$

2640 Ft. from N. Line

\_\_\_\_\_ Ft. from S. Line

\_\_\_\_\_ Ft. from E. Line

650 Ft. from W. Line

**SECTION PLAT**

|   |  |  |  |
|---|--|--|--|
|   |  |  |  |
|   |  |  |  |
| 0 |  |  |  |
|   |  |  |  |

**BROWNING POOL**

Location X

Rig up \_\_\_\_\_

Drilling and Remarks:

**RECORD**

Cased \_\_\_\_\_ in., \_\_\_\_\_ ft.

Sand \_\_\_\_\_

Gas \_\_\_\_\_

Oil A

Total Depth \_\_\_\_\_

**PRODUCTION**

1st 24 hrs. Nat. \_\_\_\_\_

1st 24 hrs. after shot \_\_\_\_\_

Gas \_\_\_\_\_ Cu. Ft.

Dry Hole \_\_\_\_\_

Abandoned \_\_\_\_\_

Date

MAR 8 - 1939

19

H. D. Hatfield Scout

Map No. 21 Sec. 20 Twp. 22 R. 10E

Well No. 57 Browning

Sinclair Prairie

Company

Contractor

COMPLETED

SECTION PLAT

C  $W\frac{1}{2}$   $W\frac{1}{2}$

2640 Ft. from N. Line

\_\_\_\_\_ Ft. from S. Line

\_\_\_\_\_ Ft. from E. Line

650 Ft. from W. Line

|  |  |  |  |
|--|--|--|--|
|  |  |  |  |
|  |  |  |  |
|  |  |  |  |
|  |  |  |  |

BROWNING POOL

Location \_\_\_\_\_

Rig up \_\_\_\_\_

Drilling and Remarks:

*Bar 82260*

*Shot 209ts.*

*2257-63*

*Pump 25 8 1/2*

RECORD

Cased \_\_\_\_\_ in., \_\_\_\_\_ ft.

Sand \_\_\_\_\_

Gas \_\_\_\_\_

Oil \_\_\_\_\_

Total Depth 2363

PRODUCTION

1st 24 hrs. Nat. \_\_\_\_\_

1st 24 hrs. after shot \_\_\_\_\_

Gas \_\_\_\_\_ Cu. Ft.

Dry Hole \_\_\_\_\_

Abandoned \_\_\_\_\_

Date

JUN 14 1939 19

S. J. LEWIS

Scout