


Section 20 Township 22 Range 10E

Well No. #S-7 Browning

Company Sinclair

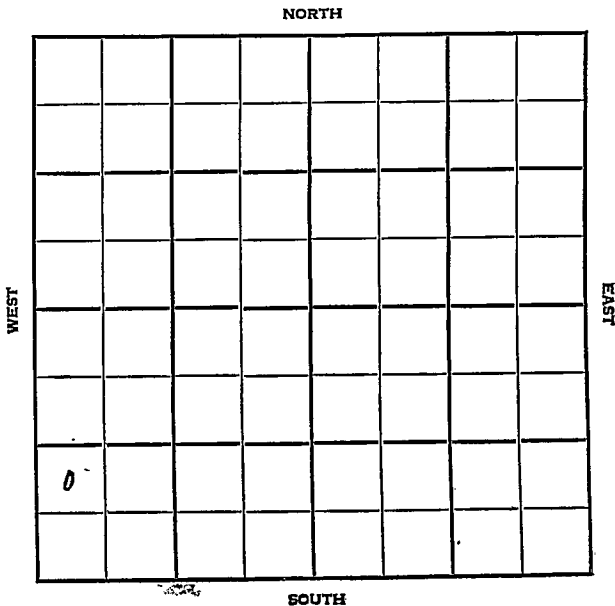

13


County Greenwood State Kansas

Sec. 20 (Blk. 22 (Sur. Rge.) 10E Map No.

Operator Sinclair

Well No. S-7 Farm Browning

Elev. _____ Location NW SW SW

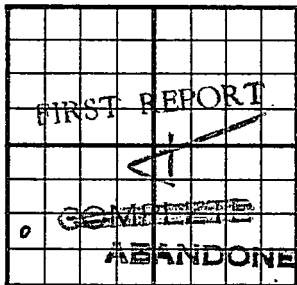

990 Ft. From S Line SW

330 Ft. From W Line Quarter

1st. Report JAN 1 2 1955

Completion JAN 1 2 1955

Remarks _____

White & Ellis - Contr.

Spudding Date _____

Drig. Data Water supply well TD 3595

11 1/2" @ 60 Bart. 2296 Miss. 2468

Rh. 2834 Viola 2922 . Simp. 2956

Arb. 2996 Roubidoux 3429 Reagan 3516

Gr. wash 3550 DST 3498-3595 open 1 hr.

Rec. 1630' wtr. 1130# TD 3595

8" @ 3025 Comp. for water supply well

FABEN GILSTRAM