


Section 20 Township 22 Range 10E

Well No. #3 Prather

Company Sunflower Drlg

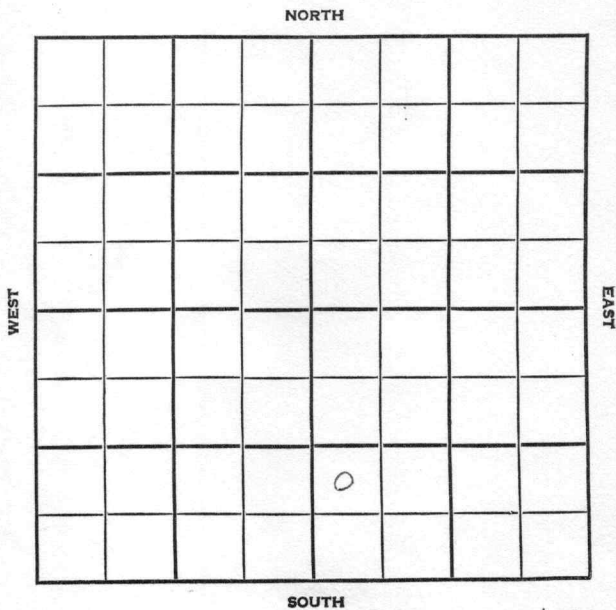

SEC.	TWP.	R.
20	22	10E

WELL NO.

#3 Prather

FARM

COMPANY

Sunflower Drlg.

CONTRACTOR

Co. tools


Browning

_____ FT. FROM N. LINE

900' _____ FT. FROM S. LINE

_____ FT. FROM E. LINE

275' _____ FT. FROM W. LINE

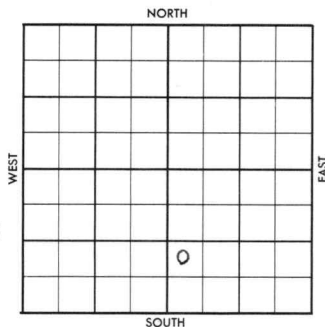

NW SW SE

ELEVATION

1956

REPORT

6-27 Comm. 6-24-56
8" @ 100/75
drlg. 940

8-1 Cored 2284-2307
5½" @ 2330
70/2291-93
P/ load
P/22 bopd, no/wtr.
Bartl. 2284-97
TD 2330'

COMPLETED

Co.

County Greenwood Elev. _____
 Sec. 20 Twp. 22 Rge. LOE
 Company Sunflower Oil
 Farm Name Prather No. 3

TOPS	DEPTH	LOG	DATUM	Loc. in Sec.
Anh.				NW SW SE
Tp.				
H.				990' SL
Tr. <u>Bartl.</u>	<u>2284-97</u>			275' WL
Dg.				
Bl.				
L.				Geol. _____
K.C.				Contr. _____
B.K.C.				
Ce.				Co. tools _____
C.				
M.				Pool _____
M.				
K.				Browsing _____
Mz.				
Ma.				
V.				
S.				
S.				
A.				
R.				
PE.				
G.				
TD.	<u>2330</u>			

Lse.

COMPLETE

No.

Date Comm. 6-24-56 AUG 1 1956

Sec.

8" @ 100/75 drlg. 940 JUL 3 '56 crd
2284-2307 5 1/2 @ 2330 /
JUL 11 '56 70/2291-93 Frac POP
P. Ld. JUL 18 '56 JUL 25 '56 AUG 1 '56 P. 22
Boyd no/wtr

T.

R.