

HOT FILE

Greenwood KANSAS

SEC.	TWP.	R.
20	22 S	10 E
WELL NO. (Browning Unit Waterflood)		
# 74 Browning Unit		FARM
COMPANY		
?		(DEVELOPMENT-OBOC)
CONTRACTOR		

Browning Field.

_____ Ft. from N. Line


350 _____ Ft. from S. Line

_____ Ft. from E. Line

970 _____ Ft. from W. Line

of NW/4

SE SW NW

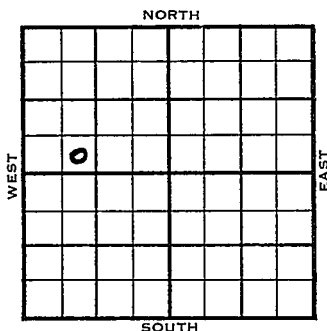

ELEVATION

REPORT

1956

2500' Bartlesville

No FR

4/23

Spudded 4-18-56.

8-5/8" @ 91'

TD 91'. WOC.

(DR#79)

4/24

Drlg. 1985'

4/25

TD 2312'. Coring.

4/26

TD 2355'. WOC - 5 1/2" @ 2290'

4/27

TD 2355'. WOC - 5 1/2" csg.

4/30

TD 2355'. WOC - 5 1/2" csg.

5/1

TD 2355'. Bailing.

5/2

TD 2355'. Drlg. plug.

5/3

TD 2355'. Cleaning out.

5/4

TD 2355'. Bailed @ 90 bbls Oil per day Rate. Open hole 2290-2355'

Bartlesville Zone - COMPLETE (DR#88)

COMPLETED