

WELL NO. **Browning Unit Water Flood**
#76-W Browning Unit "A" FARM

COMPANY **Sinclair (DEVELOPMENT-OBOC)**

CONTRACTOR

Browning Field

660 FT. FROM N. LINE


FT. FROM S. LINE

FT. FROM E. LINE

50 FT. FROM W. LINE

NW/4

W/2 NW NW

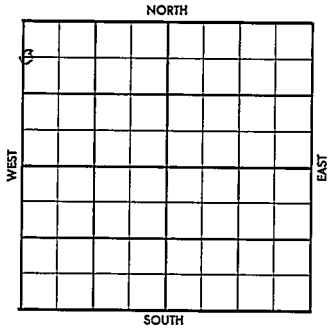

4

1956 ELEVATION REPORT

2500' Bartlesville

No FR

7-3 Spudded 6-13-56
 Drlg. 1190'. (DR#129)

7-5 Drlg. 1740'.

7-6 TD 2405'. 5 1/2" @ 2301'. WOC

7/9 TD 2405'. WOC - 5 1/2" csg.

7/10 TD 2405'. Drlg. plug.

7/11 TD 2405' "

7/12 TD 2405'. Prep to run tubing.

7/13 TD 2405'. WATER INJECTION WELL
 Open hole 2301-2390'. Bartlesville
 Zone. (DR#136)

ABANDONED