


**HOT FILE** Greenwood **KANSAS**  
 SEC. **20** TWP. **22 S 1** R. **10 E**  
 WELL NO. **(Browning Unit Wtrflood)**  
**# 79-W** Browning Unit **FARM**  
 COMPANY **Sinclair** **(DEVELOPMENT-OB<sup>0</sup>C)**  
 CONTRACTOR

**Browning Field.**

\_\_\_\_\_ FT. FROM N. LINE  
 5' \_\_\_\_\_ FT. FROM S. LINE  
 5' \_\_\_\_\_ FT. FROM E. LINE  
 \_\_\_\_\_ FT. FROM W. LINE

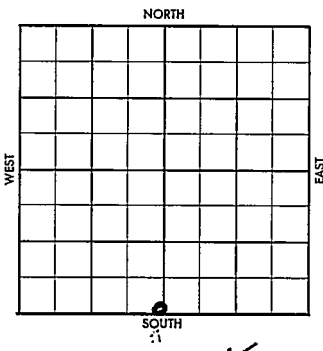

of SW/4  
 SE SE SE SW

1956	ELEVATION REPORT
	29008 Bartlesville Test <span style="float: right;"><u>No FR</u></span>
10/2	Spudded 9-16-56 Drlg. 1720' (DR#192)
10/3	TD 1978'. Fishing.
10/4	TD 2341'. Rng. EL
10/5	TD 2341'. WOC - 5 $\frac{1}{2}$ " @ 2276'
10/8	TD 2341'. 5 $\frac{1}{2}$ " csg.
10/9	TD 2341'. WOC - 5 $\frac{1}{2}$ " csg.
10/10	TD 2341'. WOC - 5 $\frac{1}{2}$ " csg.
10/11	" " "
10/12	TD 2341'. MICT
10/15	TD 2341'. Bailing.
10/16	Drlg. shoe. TD 2341'
10/17	TD 2341'. Water Injection Well Open hole 2276-2310'. Bartlesville Zone. COMPLETE (DR#203)
	<b>COMPLETED</b>