

Greenwood **KANSAS**
 (Browning Unit Wtrflood)
 20 22 S 10 E

WELL NO.

75-W Browning Unit "A" FARM

COMPANY

Sinclair (DEVELOPMENT-OBOC)

CONTRACTOR

Browning Field

_____ FT. FROM N. LINE


660 _____ FT. FROM S. LINE

_____ FT. FROM E. LINE

1320 _____ FT. FROM W. LINE

of NW/4

C S/2 NW

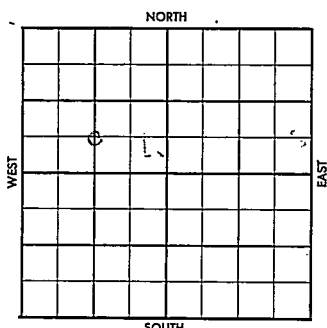

1956	ELEVATION REPORT
	2600' Bartlesville Test
6/12	Spudded 6-6-56 Drlg. 1160' (DR#114) <i>No FR</i>
6/13	Drlg. 1465'
6/14	Drlg. 1775'
6/15	Drlg. 2125'
6/18	TD 2343'. Prep to run csg.
6/19	TD 2343'. WOC - 5 1/2" @ 2273'
6/20	TD 2343'. 5 1/2" csg.
6-21	TD 2343'. WOC
6-22	TD 2343'. WOC
6-25	TD 2343'. WOC
6-26	TD 2343'. Prep to complete
6-27	TD 2343'. " "
6-28	TD 2343'. <u>Water Injection Well.</u>
	Open Hole 2273-2333'. BARTLESVILLE ZN. (DR #126)