

HOT FILE Greenwood KANSAS

SEC. 20 TWP. 22 S R. 10 E

WELL NO. # 87 Browning Unit "A" (Browning Unit Wtr. flood) FARM

COMPANY Sinclair (DEVELOPMENT-OBOC)

CONTRACTOR


Browning Field.

990 FT. FROM N. LINE

FT. FROM S. LINE

FT. FROM E. LINE

920 FT. FROM W. LINE

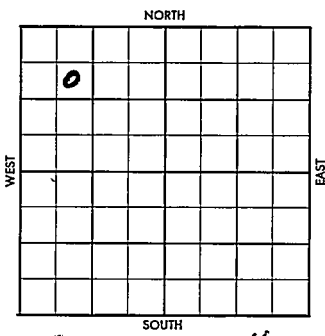

of NW/4
SE NW NW

1957	ELEVATION REPORT
	2450' Bartlesville Test <u>No FR</u>
6/5	Spudded 5-26-57 Drlg. 364' (DR#109)
6/6	Drlg. 1090'
6/7	Drlg. 1655'
6/10	Drlg. 2027'
6/11	TD 2027'. NR
6/12	TD 2389'. WOC. 5 1/2" @ 2320'
6/13	TD 2389'. WOC. 5 1/2" csg.
6/14	" " "
6/17	" " "
6/18	TD 2389' RUCT
6/19	TD 2389'. Instl. pumping Unit. Open hole 2320-2389'
6/20	TD 2389'. Instl. pumping unit. Open hole 2320-2389'
6/21	TD 2389'. " "
6/24	TD 2389'. " "
6/25	TD 2389'. " "
6/26	TD 2389'. " "
6/27	TD 2389'. " "
6/28	" " "
7/1	TD 2389'. " "

OVER

1957

7/2 TD 2389'. Instl. pumping unit.
Open hole 2320-2389'

7/3 TD 2389' " "

7/5 " " "

7/8 " " "

7/9 " " "

7/10 " " "

7/11 " " "

7/12 " " "

7/15 " " "

7/16 TD 2389'. " "

7/17 " " "

7/18 " " "

7/19 " " "

7/22 TD 2389'. Pumping on test.
Open hole 2320-2389'

7/23 TD 2389'. " "

7/24 " " "

7/25 " " "

7/26 " " "

7/29 " " "

7/30 TD 2389'. No Oil Test.
Open hole 2320-2389', Bartlesville
Zone. Complete (DR#1147)

COMPLETED