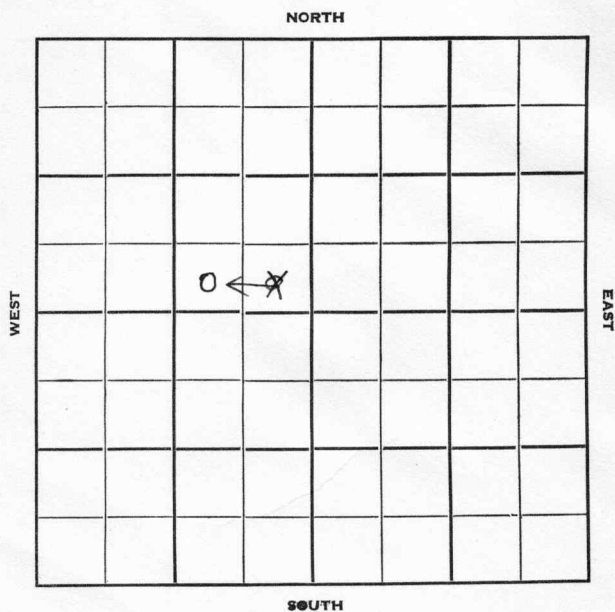


Section 21 Township 22 Range 1EWell No. #1 GreeleyCompany A. J. Rupp

Harvey

KANSAS

Sec. 21 Twp. 22 R. 1E ✓

Well No. #1 Greeley Farm

A. J. Rupp Company

Quaker Drlg. - Contr. Contractor


Wildcat

 Ft. from N. Line

330' Ft. from S. Line

990'
330' Ft. from E. Line

 Ft. from W. Line

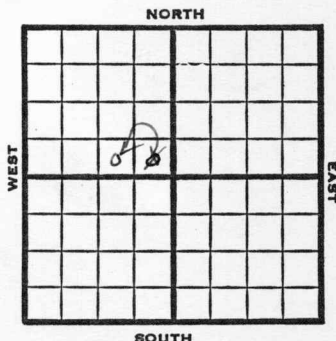

SW
SE SE NW

1951

Elev. 1478'

REPORT

4/25
5/9

Location

D&A TD 3637
8" @ 116

KC 2515 BKC 2741

Miss 2971 Kinderhook 3241

Hunton 3352 Viola 3423

Simp 3504 Arb. 3575

TD 3637

D&A


ABANDONED

Kansas

Map No. _____ Sec. 21 Twp. 22 R. 1EWell No. 1 GreeleyA. J. Rupp Company**CORRECTION** Contractor

SW SE NW

SECTION PLAT

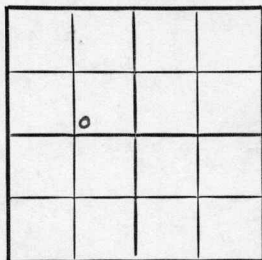

_____ Ft. from N. Line

330 Ft. from S. Line990 Ft. from E. Line

_____ Ft. from W. Line

Harvey County

Location _____

Rig up _____

Drilling and Remarks:

Reported

SE SE NW

RECORD

Cased _____ in., _____ ft.

Sand _____

Gas _____

Oil _____

Total Depth _____

PRODUCTION

1st 24 hrs. Nat. _____

1st 24 hrs. after shot _____

Gas _____ Cu. Ft.


Dry Hole _____

Abandoned _____

Date

MAY 9 1951 19J. E. TYRA

Scout

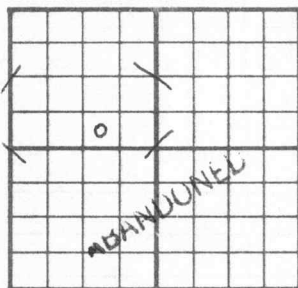County Harvey State KansasSec. 21 (Blk.
Twp.) 22 (Sur.
Rge.) 1E Map No.Operator A. J. RuppWell No. 1 Farm GreeleyElev. 1478 Location SW SE NW330 Ft. From S Line NW990 Ft. From E Line Quarter

1st. Report

Completion MAY 9 1951Remarks WildcatQuaker Drlg. - Contr.

Spudding Date

Drlg. Data D & A TD 36378" @ 116 KC 2515 B KC 2741 Miss. 2971Kinderhook 3241 Hunton 3352 Viola 3423Simp. 3504 Arb. 3575 TD 3637D & A

J. E. TYRA