

Greenwood


KANSAS

Form 51-5M-11-31-Palace

Map No. _____ Sec. 21 Twp. 22 R. 12E

Well No. 1-Frankhouser Farm
El Bar Corp Company

NORTH

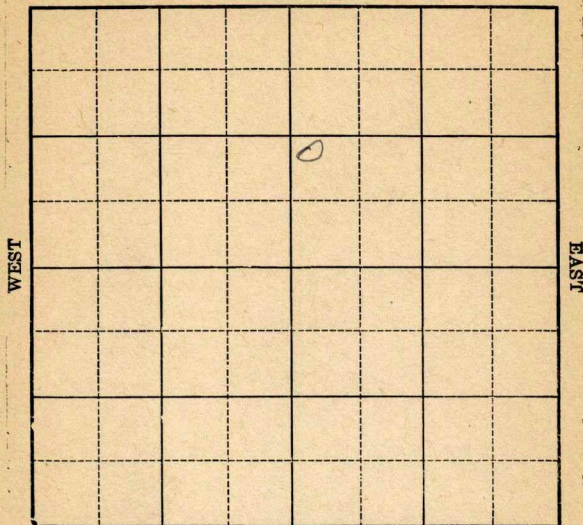

WEST

EAST

SOUTH

Location _____

Drilling Remarks _____

Rig Up _____

Drilling Remarks _____

RECORD

Cased _____ in. _____ ft.

Sand _____

Gas _____

Oil _____

Total Depth _____

PRODUCTION

1st 24 hrs. Nat. _____

1st 24 hrs. after shot _____

Gas _____ cu. ft.

Dry Hole _____

Abandoned _____

Map No. _____ Sec. 21 Twp. 22 R. 12E


Well No. 1-Frankhouser Farm
El Bar Corp Company

_____ Ft. from N. Line

1070 Ft. from S. Line

_____ Ft. from E. Line

250 Ft. from W. Line

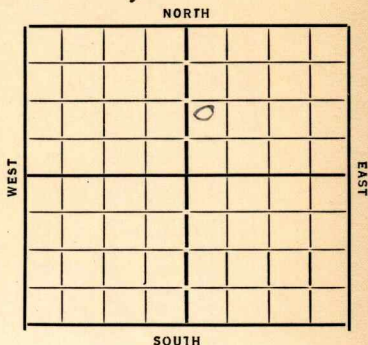

Date
1933

REPORT

7/26 location
8/2 Orly 640
8/9 " 1040'
8/17 " 1830'
8/23 Top line 1830' N0 + 9, 1860'

ABANDONED

Map No. 21 Sec. 21 Twp. 22 R. 12E

Well No. 1- Frankhouse

Ed Bar Corp Company

Contractor

SECTION PLAT

		0	

Ft. from N. Line

1070 Ft. from S. Line

Ft. from E. Line

250 Ft. from W. Line

FIRST REPORTS

Location

Rig up

Drilling and Remarks:

RECORD

Cased..... in., ft.

Sand.....

Gas.....

Oil.....

Total Depth.....

PRODUCTION

1st 24 hrs. Nat.....

1st 24 hrs. after shot.....

Gas..... Cu. Ft.

Dry Hole.....

Abandoned.....

Date

7/26/33 192

G. Marmaschek Scout

Map No. 21 Sec. 21 Twp. 22 R. 12E

Well No. 1 - Frankhouse

El Bar Corp Company

Contractor

COMPLETED

SECTION PLAT

		0	

Ft. from N. Line

1070 Ft. from S. Line

Ft. from E. Line

250 Ft. from W. Line

ABANDONED

Location

Rig up

Drilling and Remarks:

DSA

RECORD

Cased _____ in., _____ ft.

Sand T. Lime 1830

Gas _____

Oil _____

Total Depth 1860

PRODUCTION

1st 24 hrs. Nat. _____

1st 24 hrs. after shot _____

Gas _____ Cu. Ft.

Dry Hole _____

Abandoned _____

Date

8/23/33 192 O. Manschuck Secut