




Section 22 Township 22 Range 12E

Well No. #1 Norton

Company Keith Walker

Miscellaneous NORTH

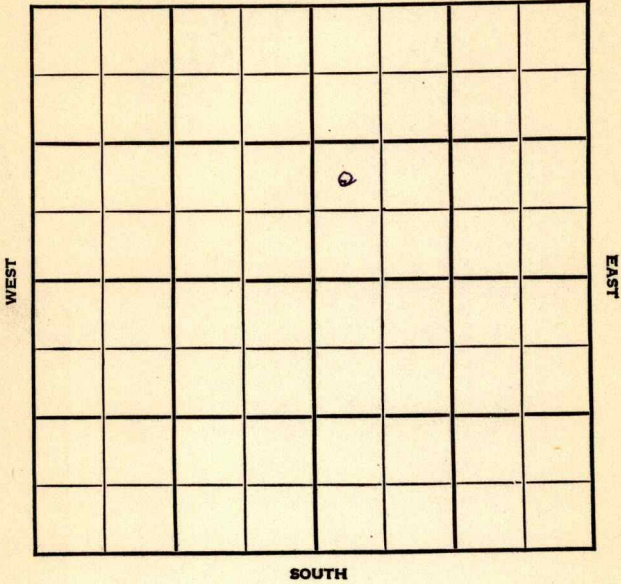



Sec. 22 Twp. 22 R. 12E

Well No. #1 Norton Farm \_\_\_\_\_

Keith Walker Company \_\_\_\_\_

Miscellaneous


\_\_\_\_\_ Ft. from N. Line

990' Ft. from S. Line

\_\_\_\_\_ Ft. from E. Line

330' Ft. from W. Line

NW SW NE

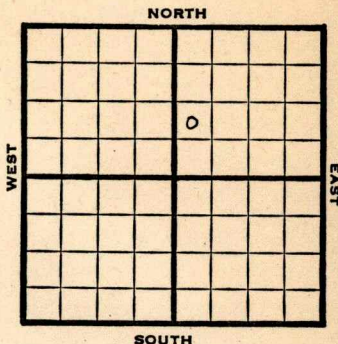

1948

**Elev. -**

**REPORT**

3/24

8" @ 42'  
**Bart 1686'**  
 4 1/2" @ 1686'  
 TD 1692'  
 RUST

3/31

**Bart 1686'**  
**Miss 1847'**  
 4 1/2" @ 1686'  
 60 qts  
 Pump 10 Pot  
 Gr. 38°  
 TD 1847'

**COMPLETED**



Map No. \_\_\_\_\_ Sec. 22 Twp. 22 R. 12E

Well No. 1 Norton

Keith Walker Company

**FIRST REPORT**

Contractor

NW SW NE

SECTION PLAT

		o	

\_\_\_\_\_ Ft. from N. Line

990 Ft. from S. Line

\_\_\_\_\_ Ft. from E. Line

330 Ft. from W. Line

Greenwood County

RECORD

Location \_\_\_\_\_

Cased \_\_\_\_\_ in., \_\_\_\_\_ ft.

Rig up \_\_\_\_\_

Sand \_\_\_\_\_

Drilling and Remarks:

Gas \_\_\_\_\_

Oil \_\_\_\_\_

8" @ 42

Total Depth \_\_\_\_\_

Bart. 1686

PRODUCTION

1st 24 hrs. Nat. \_\_\_\_\_

4 1/2" @ 1686

1st 24 hrs. after shot \_\_\_\_\_

WD 1692 RUST

Gas \_\_\_\_\_ Cu. Ft.

Dry Hole \_\_\_\_\_

Abandoned \_\_\_\_\_

Date

MAR 24 1948 19

S. J. LEWIS Scout