


Greenwood ✓

Form 51-5M-2-29-34703

Map No. **KANSAS** Sec. 22 Twp. 22 R. 12

Well No. 1-Boston Farm  
D. M. Rhodes Company

NORTH

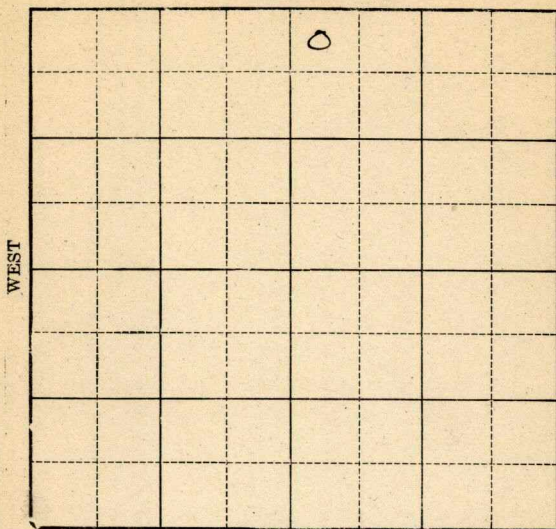

2

SOUTH

Location \_\_\_\_\_

Drilling Remarks \_\_\_\_\_

Rig Up \_\_\_\_\_

Drilling Remarks \_\_\_\_\_

**RECORD**

Cased \_\_\_\_\_ in. \_\_\_\_\_ ft.

Sand \_\_\_\_\_

Gas \_\_\_\_\_

Oil \_\_\_\_\_

Total Depth \_\_\_\_\_

**PRODUCTION**

1st 24 hrs. Nat. \_\_\_\_\_

1st 24 hrs. after shot \_\_\_\_\_

Gas \_\_\_\_\_ cu. ft.

Dry Hole \_\_\_\_\_

Abandoned \_\_\_\_\_

Greenwood

FORM 252A-5M-12-28-PETROL

Map No. **KANSAS** Sec. 22 Twp. 22 R. 12

Well No. 1- Norton Farm


W. M. Rhodes Company

330 Ft. from N. Line

\_\_\_\_\_ Ft. from S. Line

\_\_\_\_\_ Ft. from E. Line

330 Ft. from W. Line

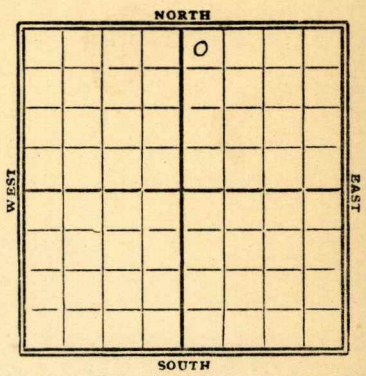

1929

Date	REPORT
3/27	Location
4/3	Spdy.
4/10	Drill 500'
4/17	" 1050'
4/24	sdy shale 1658-1712
	20' sand 1712-38
	filled up and stopped over in 10 hours
4/30	P.B. to 1729' - Pumped
	365 bbl oil & 125 water
	1st 24 hrs.
	Will run 3" tubing
5/7	sand 1712-38
	P.B. to 1729
	T.D. 1729
	250 bbls oil
	125 " water
	Pump.

*Greenwood*

21 **KANSAS** Map No. Sec. *22* Twp. *22* R. *12*

Well No. *1* *Norton*

*D.M. Rhodes* Company

Contractor

**FIRST REPORTS**

**SECTION PLAT**

*330* Ft. from N. Line

..... Ft. from S. Line

..... Ft. from E. Line

*330* Ft. from W. Line

		<i>0</i>	

Location

Rig up .....

Drilling and Remarks:

**RECORD**

Cased..... in., ..... ft.

Sand .....

Gas .....

Oil .....

Total Depth .....

**PRODUCTION**

1st 24 hrs. Nat. ....

1st 24 hrs. after shot .....

Gas..... Cu. Ft.

Dry Hole .....

Abandoned .....

Date

**MAR 27 1929**

192.....

**CHAS. L. SHERWOOD**

Scout

KANSAS

Map No. \_\_\_\_\_ Sec. 22 Twp. 22 R. 12E

Well No. 21 Norton

D. M. Rhodes Company

Contractor

SECTION PLAT

330 Ft. from N. Line  
\_\_\_\_ Ft. from S. Line  
\_\_\_\_ Ft. from E. Line  
330 Ft. from W. Line

		0	

COMPLETED

Location \_\_\_\_\_

Rig up \_\_\_\_\_

Drilling and Remarks:

Sand 1712 & 38  
P.B. & 1729  
250 & 4 oil  
125 & 4 water

RECORD

Cased \_\_\_\_\_ in., \_\_\_\_\_ ft.  
Sand \_\_\_\_\_  
Gas \_\_\_\_\_  
Oil \_\_\_\_\_  
Total Depth 1729

PRODUCTION

1st 24 hrs. Nat. \_\_\_\_\_  
1st 24 hrs. after shot \_\_\_\_\_  
Gas \_\_\_\_\_ Cu. Ft.  
Dry Hole \_\_\_\_\_  
Abandoned \_\_\_\_\_

Date

MAY 8 1929 192

CHAS. L. SHERWOOD

Scout