


Section 22 Township 22 Range 12E

Well No. 5 Norton

Company E. C. Murphy

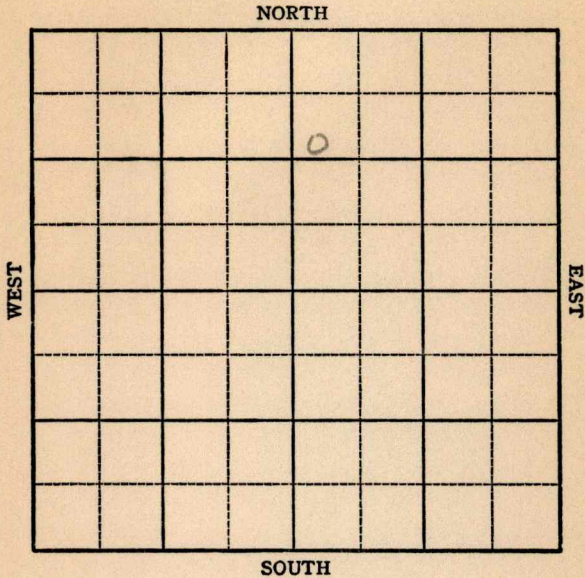

KANSAS

Greenwood



Sec. 22 Twp. 22 R. 12-E

Well No. 5 Norton Farm

E. C. Murphy Company


Miscellaneous

990 Ft. from N. Line

_____ Ft. from S. Line

_____ Ft. from E. Line

330 Ft. from W. Line

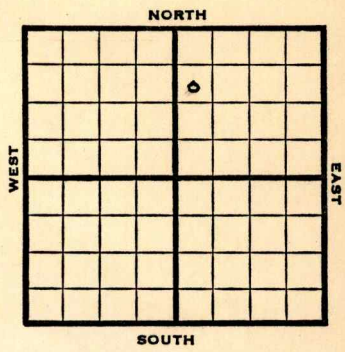

SW NW NE

1947

REPORT

9/3

7" @ 1692'
Bart. 1700'
 TD 1714'
 Pump 100' oil & 60 water
 Pot.
 Total Depth 1714'

FIRST REPORT
g
COMPLETED

Map No. 21 Sec. 22 Twp. 22 R. 12E

Well No. 5 Norton

E. C. Murphy Company

FIRST REPORT Contractor

SW NW NE

and
COMPLETE
SECTION PLAT

990 Ft. from N. Line

_____ Ft. from S. Line

_____ Ft. from E. Line

330 Ft. from W. Line

		o	

Greenwood County

Location _____

Rig up _____

Drilling and Remarks:

7" @ 1692
Bart. 1700
TD 1714
Pump 100' oil
& 60 water
Pot.

RECORD

Cased _____ in., _____ ft.

Sand _____

Gas _____

Oil _____

Total Depth 1714

PRODUCTION

1st 24 hrs. Nat. _____

1st 24 hrs. after shot _____

Gas _____ Cu. Ft.

Dry Hole _____

Abandoned _____

Date

SEP 3 1947 19

S. J. LEWIS Scout