



Map No. **KANSAS** Sec. 22 Twp. 22 R. 12<sup>E</sup>

Well No. 1-<sup>"C"</sup> Norton Farm  
Empire O&R Company


NORTH

..... Ft. from N. Line

990 Ft. from S. Line

..... Ft. from E. Line

990 Ft. from W. Line

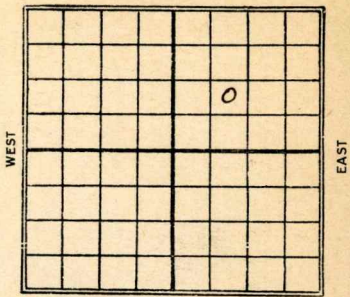

SOUTH

1929

Date REPORT

Date	REPORT
8/28	Location
9/14	Bldg Rig
9/11	Spdy
9/18	Wrl 845'
9/25	" 1570'
10/2	sand 1701-16'
	swab 105 bbl oil & 15 " water
	shot 40 qtz - Cly out
10/9	sand 1701-16'
	I.D. 1716'
	170 bbls oil
	75 " water
	Comp

*Sherwood*

Map No. **KANSAS** Sec. *22* Twp. *22* R. *12* <sup>E</sup>

Well No. *21* *1 "C"* *Norton*

*Empire Oil Co.* Company

Contractor

**FIRST REPORTS**

\_\_\_\_\_ Ft. from N. Line

*990* Ft. from S. Line

\_\_\_\_\_ Ft. from E. Line

*990* Ft. from W. Line

**SECTION PLAT**

		o	

Location           ✓          

Rig up \_\_\_\_\_

Drilling and Remarks:

**RECORD**

Cased \_\_\_\_\_ in., \_\_\_\_\_ ft.

Sand \_\_\_\_\_

Gas \_\_\_\_\_

Oil \_\_\_\_\_

Total Depth \_\_\_\_\_

**PRODUCTION**

1st 24 hrs. Nat. \_\_\_\_\_

1st 24 hrs. after shot \_\_\_\_\_

Gas \_\_\_\_\_ Cu. Ft.

Dry Hole \_\_\_\_\_

Abandoned \_\_\_\_\_

Date

**AUG 28 1929**

**CHAS. L. SHERWOOD**

*Greenwood*

Map No. **KANSAS** Sec. *22* Twp. *22* R. *12*

Well No. *1 "C" Horton*

*Empire O & A* Company

Contractor

**COMPLETE**

**SECTION PLAT**

.....Ft. from N. Line

*990* Ft. from S. Line

.....Ft. from E. Line

*990* Ft. from W. Line

		0	

Location.....

Rig up.....

Drilling and Remarks:

*170 lbs oil  
75 lbs water*

**RECORD**

Cased.....in., .....ft.

Sand *1701-1716*

Gas.....

Oil.....

Total Depth *1716*

**PRODUCTION**

1st 24 hrs. Nat.....

1st 24 hrs. after shot.....

Gas.....Cu. Ft.

Dry Hole.....

Abandoned.....

Date

**OCT 9 1929**

**CHAS. L. SHERWOOD**

192.....

Scout