

*Greenwood*

Map No. **KANSAS** Sec. *22* Twp. *22* R. *42*

Well No. *Shell Pet Corp* Farm \_\_\_\_\_ Company \_\_\_\_\_

NORTH

WEST

EAST

			0				

3

SOUTH

Location.....  
 Drilling Remarks  
 .....  
 .....  
Rig Up.....  
 Drilling Remarks  
 .....  
 .....  
RECORD

Cased..... in..... ft.  
 Sand.....  
 Gas.....  
 Oil.....  
 Total Depth.....

PRODUCTION


1st 24 hrs. Nat.....  
 1st 24 hrs. after shot.....  
 Gas..... cu. ft.....  
 Dry Hole.....  
 Abandoned.....

Greenwood

Map No. **KANSAS** Sec. 22 Twp. 22 R. 12

Well No. 1-1 Bees Farm  
Shell Oil Corp Company

330 Ft. from N. Line  
 \_\_\_\_\_ Ft. from S. Line  
330 Ft. from E. Line  
 \_\_\_\_\_ Ft. from W. Line

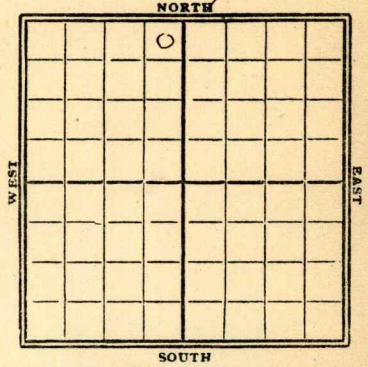

1929

Date REPORT

Date	REPORT
5/1	Co. J
5/18	Reign up
5/15	Spud 145'
5/22	Wrlg 900'
5/29	sand 1710'-22 - 14 bbl oil } 24 hr 52 " water }
6/5	sand 1710-22' TD. 1722 P.B. to 1717' shot 5 qts 14 bbl oil 14 " water Comp.

21

KANSAS

Sherwood

Map No. Sec. 22 Twp. 22 R. 12

Well No. 1

Shell Out Corp.

Company

Contractor

FIRST REPORTS

SECTION PLAT

330 Ft. from N. Line

Ft. from S. Line

330 Ft. from E. Line

Ft. from W. Line

	0		

Location R.O.S.

Rig up

Drilling and Remarks:

RECORD

Cased in., ft.

Sand

Gas

Oil

Total Depth

PRODUCTION

1st 24 hrs. Nat.

1st 24 hrs. after shot

Gas Cu. Ft.

Dry Hole

Abandoned

Date

MAY 1 1929

192 Scout

CHAS. L. SHERWOOD

21 S. M. Wood

Map No. **KANSAS** Sec. 22 Twp. 22 R. 12

Well No. *See*  
*Shell Pat. Corp* Company

Contractor

**COMPLETE**

**SECTION PLAT**

330 Ft. from N. Line  
Ft. from S. Line  
330 Ft. from E. Line  
Ft. from W. Line

	0		

Location.....

Rig up.....

Drilling and Remarks:

*FB to 1717'*  
*5/14 B&O*  
*14 B& water*

**RECORD**

Cased..... in., ..... ft.  
Sand *1710-1722*  
Gas.....  
Oil.....  
Total Depth..... *1722*

**PRODUCTION**

1st 24 hrs. Nat.....  
1st 24 hrs. after shot.....  
Gas..... Cu. Ft.  
Dry Hole.....  
Abandoned.....

Date

**JUN 5 1929**

**CHAS. L. SHERWOOD**

192..... Scout