


FORM 51 IOM 12-46 PETROL

Section 22 Township 22 Range 12E

Well No. 1 Wasson

Company C. O. Wasson

Miscellaneous NORTH

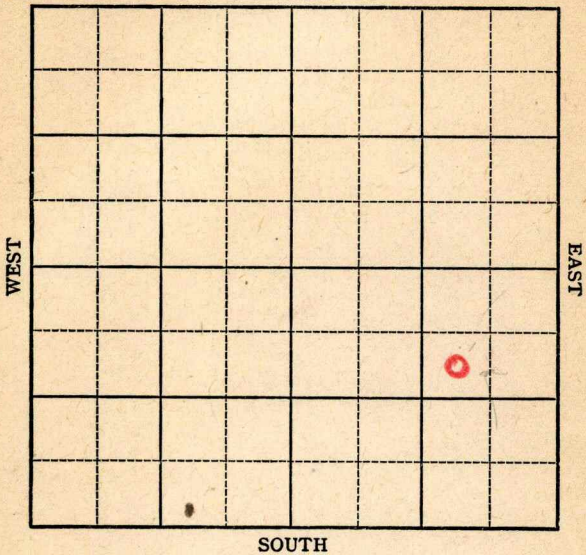

Sec. 22 Twp. 22 R. 12-E

Well No. #1 Wasson Farm

C.O. Wasson Company

Miscellaneous


990 Ft. from N. Line

 Ft. from S. Line

990 Ft. from E. Line

 Ft. from W. Line

SW NE SE

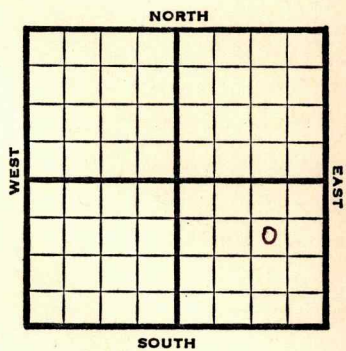

1947

REPORT

7/2 Machine
7/8 "
7/16 10" @ 748'
Drlg. 1135'
7/22 8" @ 1278
Bart 1696
TD 1735
7/30 Bart. 1696'
TD 1735'

ABANDONED

Map No. _____ Sec. 22 Twp. 22 R. 12E

Well No. 1 Wasson

C. O. Wasson Company

FIRST REPORT Contractor

SW NE SE


SECTION PLAT

990 Ft. from N. Line

_____ Ft. from S. Line

990 Ft. from E. Line

_____ Ft. from W. Line

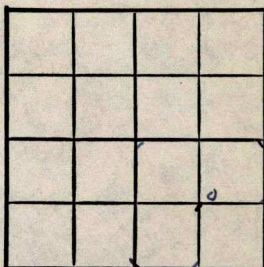

Greenwood County

Location _____

Rig up _____

Drilling and Remarks:

Machine

RECORD

Cased _____ in., _____ ft.

Sand _____

Gas _____

Oil _____

Total Depth _____

PRODUCTION

1st 24 hrs. Nat. _____

1st 24 hrs. after shot _____

Gas _____ Cu. Ft.

Dry Hole _____

Abandoned _____

Date

JUL 2 1947 19

S. J. LEWIS Scout

KansasMap No. 21 Sec. 22 Twp. 22 R. 12EWell No. 1 WassonC. O. Wasson

Company

ABANDONED

Contractor

SW NE SE

SECTION PLAT

990


Ft. from N. Line

Ft. from S. Line

990

Ft. from E. Line

Ft. from W. Line

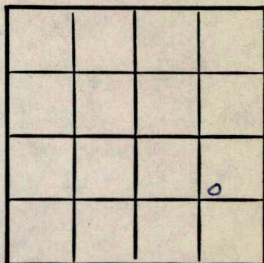

Greenwood County

Location

Rig up

Drilling and Remarks:

Bore 7/696

RECORD

Cased _____ in., _____ ft.

Sand _____

Gas _____

Oil _____

Total Depth 1235

PRODUCTION

1st 24 hrs. Nat. _____

1st 24 hrs. after shot _____

Gas _____ Cu. Ft.

Dry Hole _____

Abandoned _____

Date

JUL 30 1947

19

S. J. LEWIS

Scout