

KANSAS

Greenwood


Form 51-5M-11-31-Palace

Map No. _____ Sec. *22* Twp. *22* R. *12*^E

Well No. *1-B Wasson* Farm _____

Theta Oil Company _____

NORTH

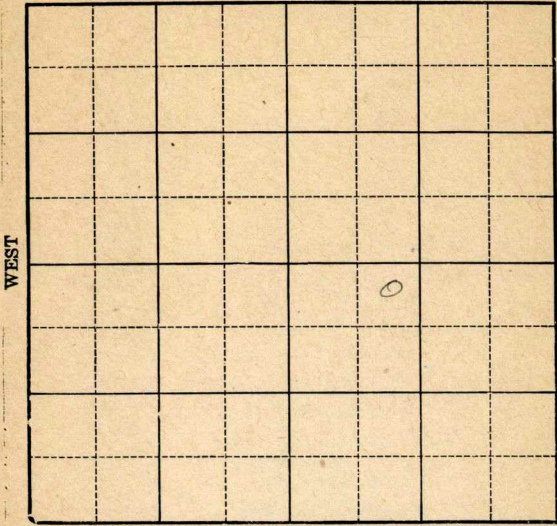

10

WEST

EAST

SOUTH

Location _____

Drilling Remarks _____

Rig Up _____

Drilling Remarks _____

RECORD

PRODUCTION

Cased _____ in. _____ ft.

1st 24 hrs. Nat. _____

Sand _____

1st 24 hrs. after shot _____

Gas _____

Gas _____ cu. ft.

Oil _____

Dry Hole _____

Total Depth _____

Abandoned _____

Greenwood

Form 252-A
5M 4-32 MPC

KANSAS

Map No. _____ Sec. 22 Twp. 22 R. 12^E

Well No. 1 "B" Wasson Farm _____


Theta Oil Company _____

220 Ft. from N. Line

_____ Ft. from S. Line

_____ Ft. from E. Line

1070 Ft. from W. Line

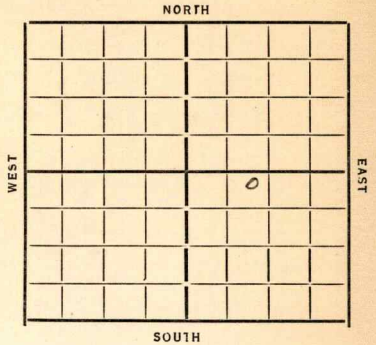

Date
1933

REPORT

3/15 machine

3/22 Regw up

3/29 Drly 400'

4/4 ← 575'

4/12 ← 1050'

4/19 sand 1686-1721 P.B. 1713 shot 60 g to
small show oil

4/26 sand 1686'-1721' J.T.O.,
P.B. 1713 shot 60 g to
Abandoned

Greenwood

E

21 **KANSAS** Map No. "B" Sec. 22 Twp. 22 R. 12

Well No. 1 *Wasson*
Theto Oil Co Company

Contractor

FIRST REPORTS

SECTION PLAT

220 Ft. from N. Line
Ft. from S. Line
Ft. from E. Line
107.0 Ft. from W. Line

		o	

Location.....

Rig up.....

Drilling and Remarks:

Machine

RECORD

Cased.....in.,ft.
Sand.....
Gas.....
Oil.....
Total Depth.....

PRODUCTION

1st 24 hrs. Nat.....
1st 24 hrs. after shot.....
Gas.....Cu. Ft.
Dry Hole.....
Abandoned.....

Date

MAR 15 1933

192.....

CHAS. L. SHERWOOD

Scout

Sherwood

E

21 **KANSAS** Map No. Sec. 22 Twp. 22 R. 12

Well No. 1 "B" *Nassau*
Thetco Oil Co Company

Contractor

COMPLETED

SECTION PLAT

220 Ft. from N. Line
Ft. from S. Line
Ft. from E. Line
1070 Ft. from W. Line

		0	

ABANDONED

Location.....

Rig up.....

Drilling and Remarks:

P.B. 1713

Shot 60'

D+a

RECORD

Cased..... in., ft.

Sand *1686-1721*

Gas.....

Oil.....

Total Depth *1721*

PRODUCTION

1st 24 hrs. Nat.....

1st 24 hrs. after shot.....

Gas..... Cu. Ft.

Dry Hole..... ✓

Abandoned..... ✓

Date

APR 26 1933

CHAS. L. SHERWOOD

192.....

Scout