


Map No. KANSAS Sec. 22 Twp. 22 R. 12^E

Well No. 210 Empire Norton Farm Company

NORTH

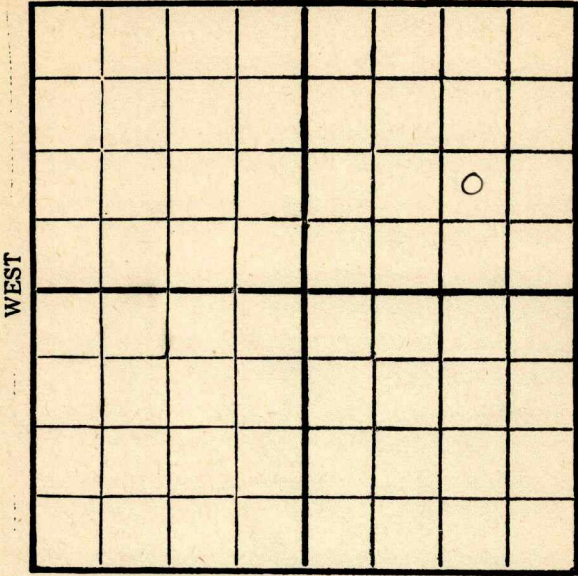

SOUTH

Location _____
Drilling Remarks _____

Rig Up _____
Drilling Remarks _____

RECORD

PRODUCTION

Cased _____ in. _____ ft.

Sand _____

Gas _____

Oil _____

Total Depth _____

1st 24 hrs. Nat. _____

1st 24 hrs. after shot _____

Gas _____ cu. ft. _____

Dry Hole _____

Abandoned _____

Sherwood

KANSAS

Map No. _____ Sec. *22* Twp. *22* R. *12*

Well No. *2c Norton*

Empire

Company

Contractor

COMPLETE

SECTION PLAT

_____ Ft. from N. Line

990 Ft. from S. Line

990 Ft. from E. Line

_____ Ft. from W. Line

			<i>0</i>

Location _____

Rig up _____

Drilling and Remarks:

40/70 lbs.

RECORD

Cased _____ in., _____ ft.

Sand *shale 1635-1715*

Gas _____

Oil _____

Total Depth *1727*

PRODUCTION

1st 24 hrs. Nat. _____

1st 24 hrs. after shot _____

Gas _____ Cu. Ft.

Dry Hole _____

Abandoned _____

Date

NOV 20 1929

192

CHAS. L. SHERWOOD

Scout

KANSAS

Greenwood

Map No. _____ Sec. 22 Twp. 22 R. 12 ^E

Well No. 2 "C" Norton

Empire Oil & Gas Co Company

Contractor

FIRST REPORTS

SECTION PLAT

_____ Ft. from N. Line

990 Ft. from S. Line

990 Ft. from E. Line

_____ Ft. from W. Line

			o

Location ✓

Rig up _____

Drilling and Remarks:

RECORD

Cased _____ in., _____ ft.

Sand _____

Gas _____

Oil _____

Total Depth _____

PRODUCTION

1st 24 hrs. Nat. _____

1st 24 hrs. after shot _____

Gas _____ Cu. Ft.

Dry Hole _____

Abandoned _____

Date

OCT 9

1929 CHAS. L. SHERWOOD

19

Scout