


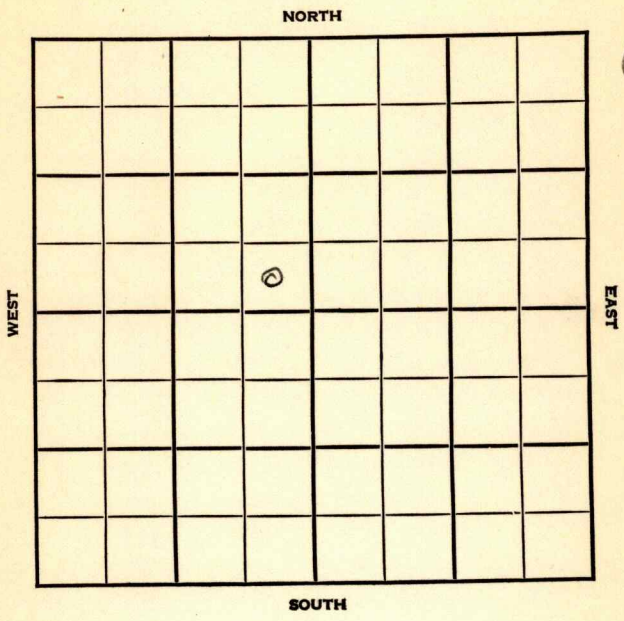

Section 22 Township 22 Range 12E

Well No. 2 Pees

Company Keith Walker



Sec. 22 Twp. 22 R. 12E

Well No. #2 Pees Farm

Keith Walker Company
Misc.


 Ft. from N. Line

330 Ft. from S. Line

330 Ft. from E. Line

 Ft. from W. Line

SE NW

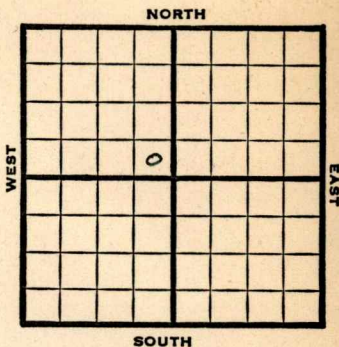

1947

REPORT

12/17 RUR

12/30 620' SG

1948
1/7 **Bart. 1675'**
TD 1690'
5" @ 1675'
RUST

1/14 **Bart. 1675'**
5" @ 1675'
30 qts.
Pump 15 Pot
36.8 Gr.
TD 1690'
Comp.

COMPLETED

Map No. 21 Sec. 22 Twp. 22 R. 12E

Well No. 2 Pees

Keith Walker Company

COMPLETE Contractor

SE NW

SECTION PLAT

_____ Ft. from N. Line

330 Ft. from S. Line

330 Ft. from E. Line

_____ Ft. from W. Line

Greenwood County

Location _____

Rig up _____

Drilling and Remarks:

Bar 1675

5" @ 1675

309 to

Pump 1500

365/24

RECORD

Cased _____ in., _____ ft.

Sand _____

Gas _____

Oil _____

Total Depth 1670

PRODUCTION

1st 24 hrs. Nat. _____

1st 24 hrs. after shot _____

Gas _____ Cu. Ft.

Dry Hole _____

Abandoned _____

Date

JAN 14 1948 19

S. J. LEWIS Scout

Kansas

Map No. _____ Sec. 22 Twp. 22 R. 12E

Well No. 2 Pees

Keith Walker Company

FIRST REPORT Contractor

SE NW

SECTION PLAT

		o	

_____ Ft. from N. Line

330 Ft. from S. Line

330 Ft. from E. Line

_____ Ft. from W. Line

Greenwood County

Location _____

Rig up _____

Drilling and Remarks:

R U R

RECORD

Cased _____ in., _____ ft.

Sand _____

Gas _____

Oil _____

Total Depth _____

PRODUCTION

1st 24 hrs. Nat. _____

1st 24 hrs. after shot _____

Gas _____ Cu. Ft.

Dry Hole _____

Abandoned _____

Date

DEC 17 1947 19

S. J. LEWIS Scout