


Greenwood
 Map No. **KANSAS** Sec. *22* Twp. *22* R. *12^E*
 Well No. *1- Masson* Farm
Empire O & R Company

330 Ft. from N. Line
 _____ Ft. from S. Line
990 Ft. from E. Line
 _____ Ft. from W. Line

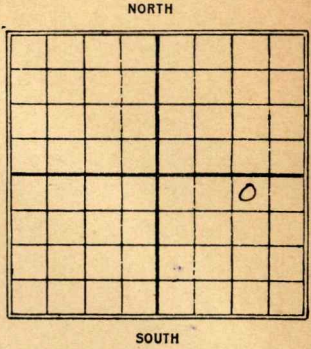

1930

Date	REPORT
<i>3/5</i>	<i>Location</i>
<i>3/12</i>	<i>Bldg rig.</i>
<i>3/19</i>	<i>Spdg. 270'</i>
<i>3/26</i>	<i>Drill. 975'</i>
<i>4/2</i>	<i>Sdy shale 1645-85'</i>
	<i>Sand 1685-1704'</i>
	<i>300' oil — will shoot</i>
<i>4/9</i>	<i>Sdy shale 1645-85'</i>
	<i>Sand 1685-1704'</i>
	<i>T.D. 1704'</i>
	<i>shot 30 qt</i>
	<i>@ 100 bbl oil</i>
	<i>Emp.</i>

Greenwood

21 Map No. Sec. 22 Twp. 22 R. 12^E

Well No. 1 Wasson

Empire Oil & Gas Co Company

Contractor

FIRST REPORTS

SECTION PLAT

330 Ft. from N. Line

Ft. from S. Line

990 Ft. from E. Line

Ft. from W. Line

			0

Location ✓

Rig up

Drilling and Remarks:

RECORD

Cased in., ft.

Sand

Gas

Oil

Total Depth

PRODUCTION

1st 24 hrs. Nat.

1st 24 hrs. after shot

Gas Cu. Ft.

Dry Hole

Abandoned

Date

MAR 5 1930

CHAS. L. SHERWOOD

192 Scout

Lyndonwood

Map No. **KANSAS** Sec. *22* Twp. *22* R. *12*

Well No. *1* *Wasson*

Empire O & A Company

Contractor

COMPLETE

SECTION PLAT

330 Ft. from N. Line

..... Ft. from S. Line

990 Ft. from E. Line

..... Ft. from W. Line

			<i>0</i>

Location.....

Rig up.....

Drilling and Remarks:

Sdy Sha 1645-85

30/100 Bls

RECORD

Cased..... in., ft.

Sand *1685-1704*

Gas.....

Oil.....

Total Depth *1704*

PRODUCTION

1st 24 hrs. Nat.....

1st 24 hrs. after shot.....

Gas..... Cu. Ft.

Dry Hole.....

Abandoned.....

Date

APR 9 1930

CHAS. L. SHERWOOD

.....192..... Scout