


Section 22 Township 22 Range 12E

Well No. #1 Wasson

Company White & Ellis

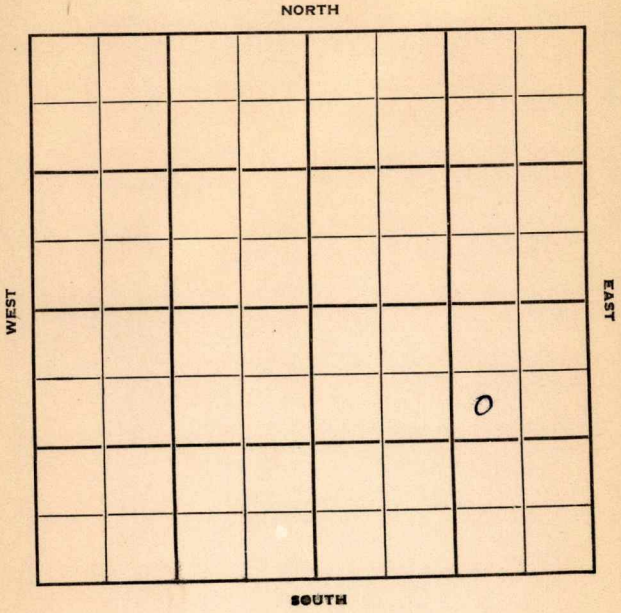

Sec. 22 Twp. 22 R. 12E

Well No. #1 Wasson Farm

White & Ellis Company

Contractor

Miscellaneous


990' Ft. from N. Line

Ft. from S. Line

990' Ft. from E. Line

Ft. from W. Line

SW NE SE

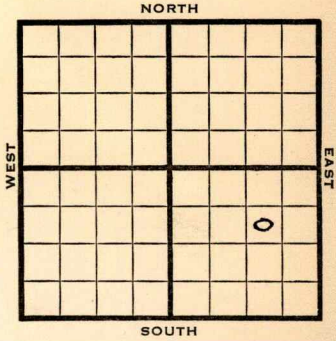

1950

Elev

REPORT

4/19

Spud 4-15-50
8" @ 60'

Drlg. 775'

5/24

8" @ 60

Bart 1692

5" @ 1692

TD 1736

PB 1709

20/1699-1709

10 qt 1688-99

D&A

ABANDONED

Map No. _____ Sec. 22 Twp. 22 R. 12E

Well No. 1 Wasson

White & Ellis Company

Contractor

SW NE SE


SECTION PLAT

990 Ft. from N. Line

_____ Ft. from S. Line

990 Ft. from E. Line

_____ Ft. from W. Line

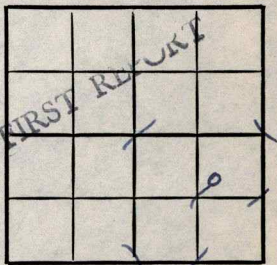

Greenwood County

Location _____

Rig up _____

Drilling and Remarks:

Spud 4-15-50

8" @ 60

drlg. 775

RECORD

Cased _____ in., _____ ft.

Sand _____

Gas _____

Oil _____

Total Depth _____

PRODUCTION

1st 24 hrs. Nat. _____

1st 24 hrs. after shot _____

Gas _____ Cu. Ft.

Dry Hole _____

Abandoned _____

Date

APR 19 1950 19

J. E. TYRA Scout

Kansas

Map No. _____ Sec. 22 Twp. 22 R. 12E

Well No. 1 Wasson

White & Ellis Company

Contractor _____

~~SW~~
~~0 W/2~~ NE SE


SECTION PLAT

990 Ft. from N. Line

_____ Ft. from S. Line

990 Ft. from E. Line

_____ Ft. from W. Line

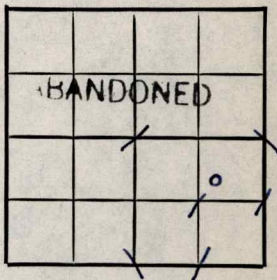

Greenwood

Location _____

Rig up _____

Drilling and Remarks:

8" C 60
 Bart. 1692
 5" C 1692
 T.D. 1736
 PB 1709
 20/1699-1709
 10 qt. 1688-99
 D+A

RECORD

Cased _____ in., _____ ft.

Sand _____

Gas _____

Oil _____

Total Depth _____

PRODUCTION

1st 24 hrs. Nat. _____

1st 24 hrs. after shot _____

Gas _____ Cu. Ft.

Dry Hole _____

Abandoned _____

Date

MAY 2 1950

19

J. E. TYRA

Scout