


Section 22 Township 22 Range 12E

Well No. 1 Watson

Company W. E. Ellis

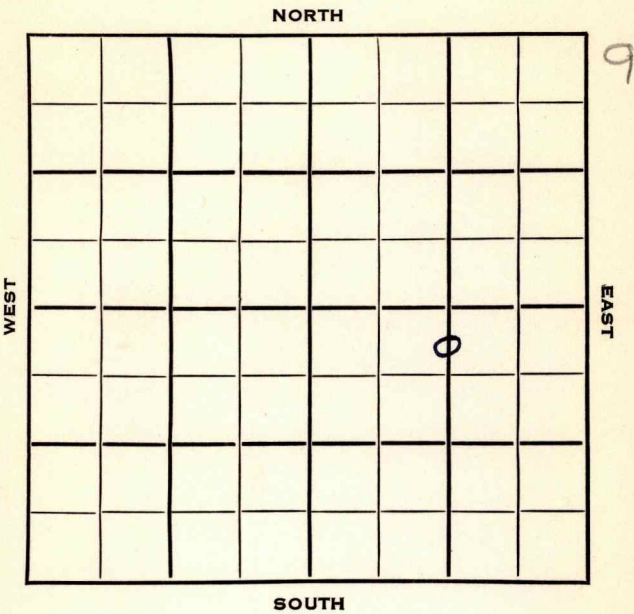

Greenwood KANSAS

SEC.	TWP.	R.
22	22	12 E

WELL NO.

1 Watson

FARM

COMPANY

W. E. Ellis

CONTRACTOR

Barker

Lamont Pool

330


Ft. from N. Line

Ft. from S. Line

1320

Ft. from E. Line

Ft. from W. Line

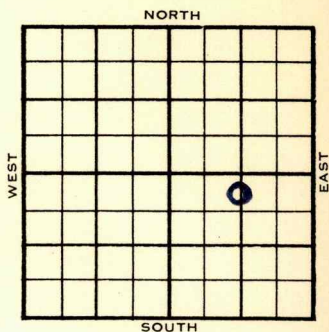C N $\frac{1}{2}$ N $\frac{1}{2}$ SE

	ELEVATION	REPORT
1953		
11/11	Spud 10-30-53 10" @ 725' Drlg. 1065'	
12/16	Spud 10-30-53 D&A TD 1706' 10" @ 725' 8" @ 1225' Bart 1686' TD 1706' 5 $\frac{1}{2}$ " @ 1686' 10 qt/Nitro blew up @ 500' Abandoned	

ABANDONED

(Blk.)
(Twp.)

W. E. Ellis

1

Location

FIRST REPORT

330

1320

NOV

Completion

Remarks

Barker - Contr.

10-30-53

Lamont Pool

10¹¹

J. G. McGEHEE

County Greenwood State Kansas
 Sec. 22 (Blk.) 22 (Sur.) 12E Map No.
 Operator W. E. Ellis
 Well No. 1 Farm Watson
 Elev. Location C N $\frac{1}{2}$ N $\frac{1}{2}$ SE



330 Ft. From N Line SE
1320 Ft. From E Line Quarter
 1st. Report
 Completion DEC 16 1953
 Remarks Lamont Pool
Barker - Contr.
 Spudding Date 10-30-53

Drlg. Data D & A TD 1706
10" @ 725 8" @ 1225 Bart. 1686
TD 1706 5 $\frac{1}{2}$ " @ 1686 10 qt/
Nitro blew up at 500'
Aband.

J. G. McGEHEE