


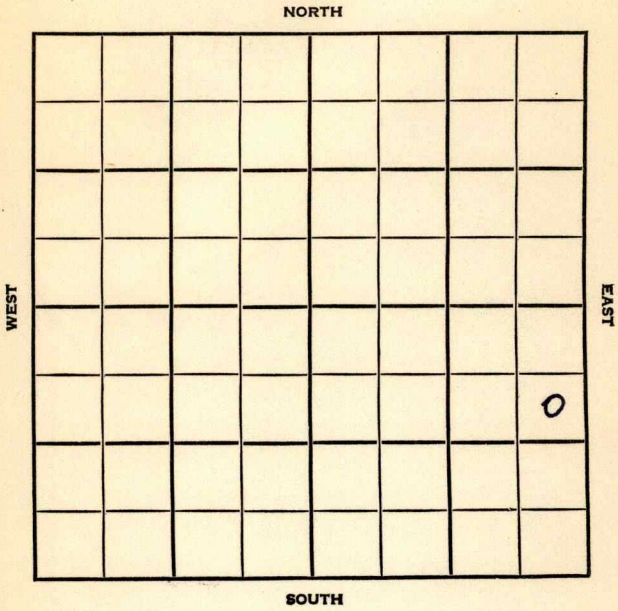

Section 22 Township 22 Range 12E

Well No. 2 Watson

Company W/ E. Ellis



Greenwood Kansas

SEC.	22	TWP.	22	R.	12E
------	----	------	----	----	-----

WELL NO. FARM
 2 Watson

COMPANY
 W. E. Ellis

CONTRACTOR
 Geneva


Lamont Pool

990 _____ Ft. from N. Line

_____ Ft. from S. Line

330 _____ Ft. from E. Line

_____ Ft. from W. Line

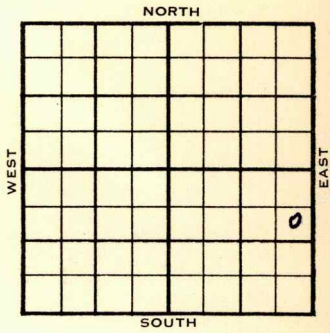

SE NE SE

1954	ELEVATION	REPORT
------	-----------	--------

6/30 8" @ 40
 Drlg. 1601

7/21 Spud 6-23-54 Oil well TD 1728
 8" @ 40 **Bart 1692** 4" @ 1694
 TD 1728 frac. Comp. 18 BOPD

COMPLETED

County Greenwood State Kansas

Sec. 22 (Blk. 22 (Sur. 12E (Rge. 12E Map No.

Operator W. E. Ellis

Well No. 2 Farm Watson

Elev. _____ Location SE NE SE

COMPLETE

990 Ft. From N Line SE

330 Ft. From E Line Quarter

1st. Report _____

Completion JUL 21 1954

Remarks Lamont Pool

Geneva - Contr.

Spudding Date 6-23-54

Drlg. Data Oil well TD 1728

8" @ 40 Bart. 1692 4" @ 1694

TD 1728 frac Comp. 18 bopd