

Map No. _____ Sec. 22 Twp. 22 R. 11


Well No. 1 Bensie Farm
J. H. Millken Company

_____ Ft. from N. Line

330 Ft. from S. Line

_____ Ft. from E. Line

330 Ft. from W. Line

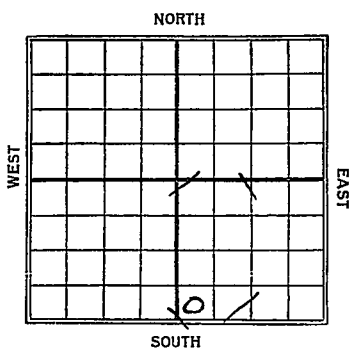

Date	REPORT
1923	
4/20	Location.
6/10	Sand 1936-64 - Shot
	500ft. 10 Bbl.

Map No. KANSAS 21 Sec. 23 Twp. 22 R. 11

Well No. 1 Bense

J.H. Milliken Company

Contractor

FIRST REPORT

_____ Ft. from N. Line

330' Ft. from S. Line

_____ Ft. from E. Line

330' Ft. from W. Line

SECTION PLAT

Location ✓✓

Rig up _____

Drilling and Remarks:

RECORD

Cased _____ in., _____ ft.

Sand _____

Gas _____

Oil _____

Total Depth _____

PRODUCTION

1st 24 hrs. Nat. _____

1st 24 hrs. after shot _____

Gas _____ Cu. Ft.

Dry Hole _____

Abandoned _____

Date

M. A. BENEAR

APR 20 1933

Scout

Map No. KANSAS 21 Sec. 22 Twp. 22 R. 11

Well No. 1 Bersie

J. H. Milliken Company

Contractor

COMPLETED SECTION PLAT

_____ Ft. from N. Line

330 Ft. from S. Line

_____ Ft. from E. Line

330 Ft. from W. Line

		0	

Location _____

Rig up _____

Drilling and Remarks:

*pay { 1936
1964-70,
50/10 lbs.*

RECORD

Cased _____ in., _____ ft.

Sand _____

Gas _____

Oil _____

Total Depth _____

PRODUCTION

1st 24 hrs. Nat. _____

1st 24 hrs. after shot _____

Gas _____ Cu. Ft.

Dry Hole _____

Abandoned _____

Date

JUN 10 1923

M. A. BENEAN

Scout