

Map No. K Sec. 22 Twp. 22 R. 11^E


Well No. 2 Berse Farm
Milligan Company

_____ Ft. from N. Line

990 Ft. from S. Line

330 Ft. from E. Line

_____ Ft. from W. Line

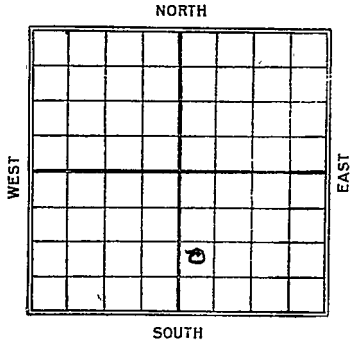

Date
1924

REPORT

10/8

Spud

11/19

1929-1933 T.D. 1978'

100 gts 120 Bbls

K21
Map No. **KANSAS** Sec. 22 Twp. 22 R. 11 ^EWell No. 2 BessieMilligan Company

Contractor

FIRST REPORT

SECTION PLAT

_____ Ft. from N. Line

990 Ft. from S. Line330 Ft. from E. Line

_____ Ft. from W. Line

		o	

Location _____

Rig up _____

Drilling and Remarks:

spud

RECORD

Cased _____ in., _____ ft.

Sand _____

Gas _____

Oil _____

Total Depth _____

PRODUCTION

1st 24 hrs. Nat. _____

1st 24 hrs. after shot _____

Gas _____ Cu. Ft.

Dry Hole _____

Abandoned _____

Date OCT 8 1924

_____ 192_____

M. A. BENEAR

Scout

Map No. 21 **ANGAS** Sec. 22 Twp. 22 R. 11 ^E

Well No. # 2 Bersie

Milligan et al Company

1 Contractor

COMPLETED

SECTION PLAT

_____ Ft. from N. Line

990' Ft. from S. Line

_____ Ft. from E. Line

330' Ft. from W. Line

		o	

Location _____

Rig up _____

Drilling and Remarks:

Broken-5.1929-1933

7.0, 1933

Bottom-5.1968

T.D. 1978

100/120 bbls.

RECORD

Cased _____ in., _____ ft.

Sand _____

Gas _____

Oil _____

Total Depth _____

PRODUCTION

1st 24 hrs. Nat. _____

1st 24 hrs. after shot _____

Gas _____ Cu. Ft.

Dry Hole _____

Abandoned _____

Date

NOV 19 1924

M. A. BENEAR

Scout