

Map No. Kans Sec. 22 Twp. 22 R. 11

Well No. 2 Cronett Farm


Phillips Pet Company

_____ Ft. from N. Line

990 Ft. from S. Line

_____ Ft. from E. Line

990 Ft. from W. Line

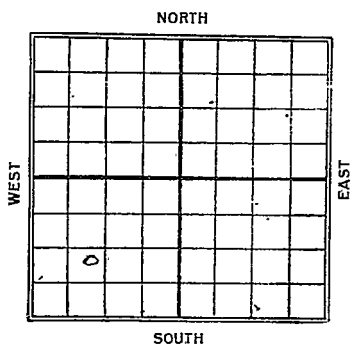

| Date | REPORT |
|--------------|-------------------------------------|
| <u>1924</u> | |
| <u>11/6</u> | <u>Rig</u> |
| <u>11/26</u> | <u>Dly 900'</u> |
| <u>12/17</u> | <u>Broken sand 1910-36.</u> |
| | <u>" " 1957-97</u> |
| | <u>shot 120 gts will dly deeper</u> |
| <u>1925</u> | |
| <u>1/14</u> | <u>D. + Q. 2070'</u> |
| | |
| | |
21 **KANSAS** Map No. Sec. 22 Twp. 22 R. 11

Well No. 2 Croust
Phillips Pet. Company

Contractor

FIRST REPORT

SECTION PLAT

_____ Ft. from N. Line

990 Ft. from S. Line

_____ Ft. from E. Line

990 Ft. from W. Line

| | | | |
|---|--|--|--|
| | | | |
| | | | |
| | | | |
| 0 | | | |

Location _____

Rig up _____

Drilling and Remarks:

Rig

RECORD

Cased _____ in., _____ ft.

Sand _____

Gas _____

Oil _____

Total Depth _____

PRODUCTION.

1st 24 hrs. Nat. _____

1st 24 hrs. after shot _____

Gas _____ Cu. Ft.

Dry Hole _____

Abandoned _____

Date

NOV 6 1924
192

M. A. BENEAR Scout

21 **KANSAS** Map No. Sec. 22 Twp. 22 R. 11 E

Well No. 2 *Crowell*

Phillips Pet Company

Contractor

ABANDONED

SECTION PLAT

----- Ft. from N. Line

990 Ft. from S. Line

----- Ft. from E. Line

990 Ft. from W. Line

| | | | |
|----------|--|--|--|
| | | | |
| | | | |
| | | | |
| <i>0</i> | | | |

Location -----

Rig up -----

Drilling and Remarks:

LQ + A
2070'

RECORD

Cased ----- in., ----- ft.

Sand -----

Gas -----

Oil -----

Total Depth -----

PRODUCTION

1st 24 hrs. Nat. -----

1st 24 hrs. after shot -----

Gas ----- Cu. Ft.

Dry Hole -----

Abandoned -----

Date

1/14 192 *5*

M. A. BENEAR

Scout