


Map No. Kansas Sec. 22 Twp. 22 R. 14Well No. 3 Cronett FarmPhillips Pet Company

NORTH

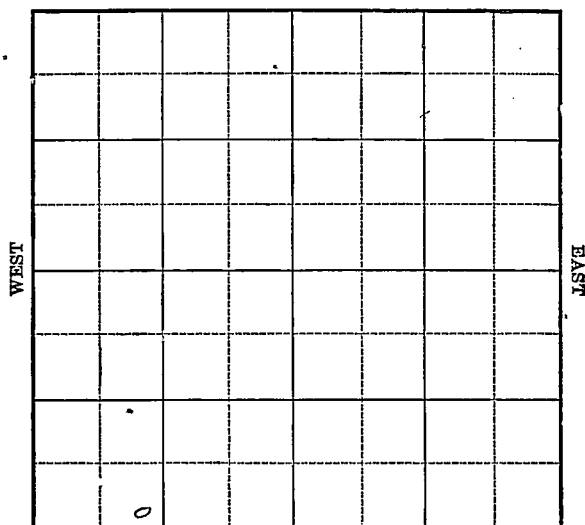

SOUTH

Location _____

Drilling Remarks

Rig Up _____

Drilling Remarks

RECORD

Cased _____ in. _____ ft.

Sand _____

Gas _____

Oil _____

Total Depth _____

PRODUCTION

1st 24 hrs. Nat. _____

1st. 24 hrs. after shot _____

Gas _____ cu. ft.

Dry Hole _____


Abandoned _____

Map No. Kans Sec. 22 Twp. 22 R. 11Well No. 3 Cronett FarmPhillips Pet Company

_____ Ft. from N. Line

330 Ft. from S. Line

_____ Ft. from E. Line

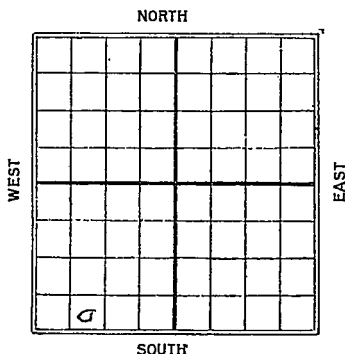990 Ft. from W. Line

Date

1925

REPORT

2/8Rig up3/301926-40 T.D. 1976Shot 80 gts 64 Bbls

Map No. 21 **KANSAS** Sec. 22 Twp. 22 R. 11
 Well No. 3 Oravell
Phillips Pet. Company
 Contractor

FIRST REPORT

SECTION PLAT

_____ Ft. from N. Line

330 Ft. from S. Line

_____ Ft. from E. Line

990 Ft. from W. Line

Location _____

Rig up ✓ ✓

Drilling and Remarks:

RECORD

Cased _____ in., _____ ft.

Sand _____

Gas _____

Oil _____

Total Depth _____

PRODUCTION

1st 24 hrs. Nat. _____

1st 24 hrs. after shot _____

Gas _____ Cu. Ft.

Dry Hole _____

Abandoned _____

Date

2/8 1925 M. A. BENEAR Scout

Map No. 21 **KANSAS** Sec. 22 Twp. 22 R. 11Well No. 3 CrawettPhillips Pet. Company

Contractor

COMPLETED**SECTION PLAT**

Ft. from N. Line

330 Ft. from S. Line

Ft. from E. Line

990 Ft. from W. Line

0			

Location

Rig up

Drilling and Remarks:

shot 80, gts**RECORD**

Cased _____ in., _____ ft.

Sand 1926-1940

Gas _____

Oil _____

Total Depth 1976**PRODUCTION**

1st 24 hrs. Nat. _____

1st 24 hrs. after shot 64

Gas _____ Cu. Ft.

Dry Hole _____

Abandoned _____

Date

3/30 1925**M. A. BENEAR**

Scout