


Map No. Kans Sec. 22 Twp. 22 R. 11Well No. 3 Bersie FarmHenderson + Holding Company

NORTH

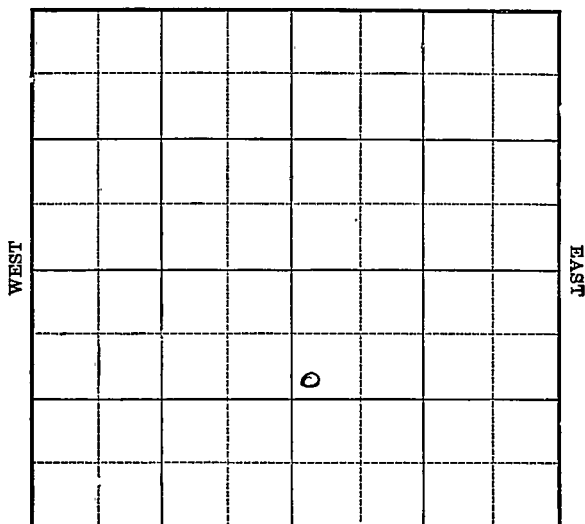

SOUTH

Location _____

Drilling Remarks _____

RECORD

Cased _____ in. _____ ft.

Sand _____

Gas _____

Oil _____

Total Depth _____

Rig Up _____

Drilling Remarks _____

PRODUCTION

1st 24 hrs. Nat. _____

1st. 24 hrs. after shot _____

Gas _____ cu. ft.


Dry Hole _____

Abandoned _____

Map No. Kan Sec. 22 Twp. 22 R. 11Well No. 3 Bersie FarmHenderson & Holden Company990 Ft. from N. Line

_____ Ft. from S. Line

_____ Ft. from E. Line

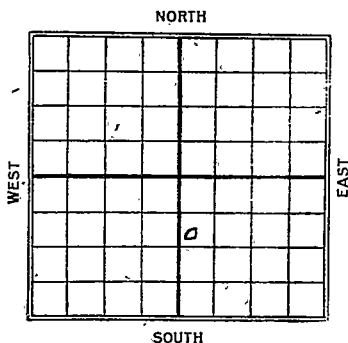330 Ft. from W. Line

Date

REPORT

192411/26 R. O. G.12/17 set 10" - 10 4/8"19251/14 Sand 1916 - 59 1/2 Swabbed
175 Bbls 1st 15 hours

21 **KANSAS** Map No. Sec. 22 Twp. 22 R. 11
 Well No. 3 *Bersie*
H. Henderson & Halden Company
WGS-Milligan et al Contractor

FIRST REPORT

990 Ft. from N. Line

Ft. from S. Line

Ft. from E. Line

330 Ft. from W. Line

SECTION PLAT

		0	

Location

Rig up

Drilling and Remarks:

R.O. G.

RECORD

Cased in., ft.

Sand

Gas

Oil

Total Depth

PRODUCTION

1st 24 hrs. Nat.

1st 24 hrs. after shot

Gas Cu. Ft.

Dry Hole

Abandoned

Date

NOV 26 1924

M. A. BENEAR

192

Scout

21 **KANSAS** Map No. _____ Sec. 22 Twp. 22 R. 11

Well No. 3 Bessie

Henderson & Holden & Milligan Company

Contractor _____


COMPLETED SECTION PLAT

990 Ft. from N. Line

_____ Ft. from S. Line

_____ Ft. from E. Line

330 Ft. from W. Line

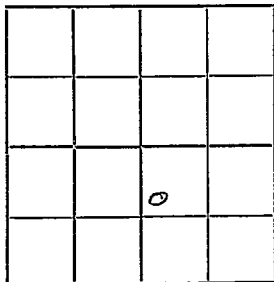

Location _____

Rig up _____

Drilling and Remarks:

sand 1916-1959 1/2
swabbed 175 lbs
1st 15 hrs not

RECORD

Cased _____ in., _____ ft.

Sand _____

Gas _____

Oil _____

Total Depth _____

PRODUCTION

1st 24 hrs. Nat. _____

1st 24 hrs. after shot _____

Gas _____ Cu. Ft.

Dry Hole _____

Abandoned _____

Date

M. A. BENEAR

1/14 192 5

Scout