
Form 51 SM 11-23 13896

Map No. K Sec. 22 Twp. 22 R. 11 E

Well No. 3 South Farm

Tidal Oil Company

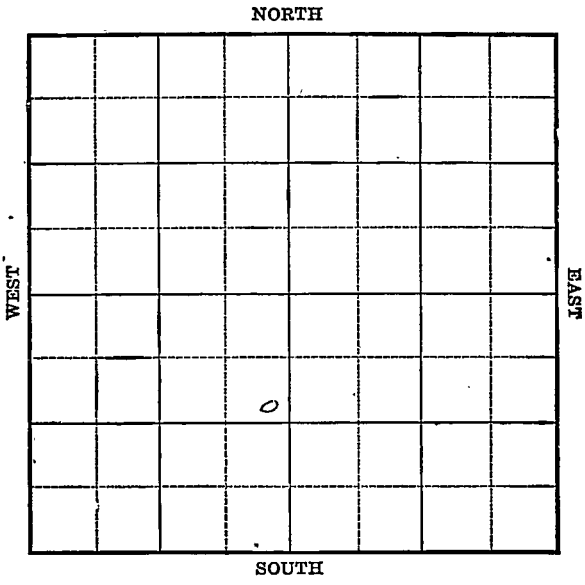

11

Location _____

Drilling Remarks:

Rig Up _____

Drilling Remarks:

RECORD

Cased _____ in. _____ ft.

Sand _____

Gas _____

Oil _____

Total Depth _____

PRODUCTION

1st 24 hrs. Nat. _____

1st 24 hrs. after shot _____

Gas _____ cu. ft.

Dry Hole _____

Abandoned _____

Form 252A 5M 2-24 15129

Map No. Kans Sec. 22 Twp. 22 R. 11 E

Well No. 3 South Farm


Tidal Oil Company

990 Ft. from N. Line

_____ Ft. from S. Line

330 Ft. from E. Line

_____ Ft. from W. Line

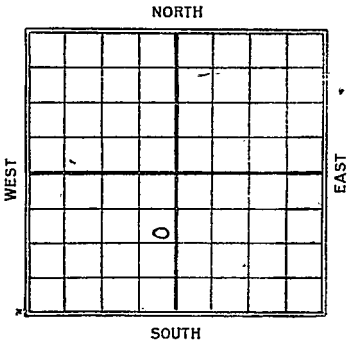

C.

Date 1926	REPORT
11/6	Timbers
11/26	Dlg 540'
12/10	Sand - 1923 - 51 - J.D.
	60 / 140 bbls

Form 26—1M Bks.—3-23—11959.

Map No. 21 KANSAS Sec. 22 Twp. 22 R. 11E

Well No. 3 South

Tidal Oil Company

_____ Contractor

FIRST REPORT


990 Ft. from N. Line

_____ Ft. from S. Line

330 Ft. from E. Line

_____ Ft. from W. Line

SECTION PLAT

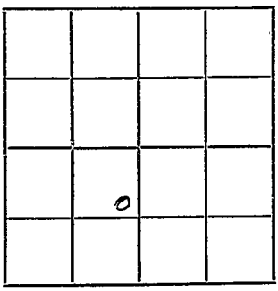

Location _____

Rig up _____

Drilling and Remarks:

Timbers

RECORD

Cased _____ in., _____ ft.

Sand _____

Gas _____

Oil _____

Total Depth _____

PRODUCTION

1st 24 hrs. Nat. _____

1st 24 hrs. after shot _____

Gas _____ Cu. Ft.

Dry Hole _____

Abandoned _____

Date NOV 6 1924

_____ 192____

M. A. BENEAR

_____ Scout

Form 26—1M Bks.—3-23—11959.

Map No. Strike Sec. vv Twp. vv R. 11

Well No. 2 South

Tidal Oil Co Company

Contractor

COMPLETED

990 Ft. from N. Line


Ft. from S. Line

330 Ft. from E. Line

Ft. from W. Line

Corrected from #4 to #3

SECTION PLAT

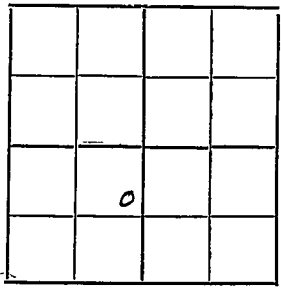

Location

Rig up

Drilling and Remarks:

60/40 bbls

RECORD

Cased in., ft.

Sand 1923-51

Gas

Oil

Total Depth 1951

PRODUCTION

1st 24 hrs. Nat.

1st 24 hrs. after shot

Gas Cu. Ft.

Dry Hole

Abandoned

Date

JUL 31 1925 192

CHAS. L. SHERWOOD Scout