


Map No. Kans Sec. 22 Twp. 22 R. 11 ✓

Well No. A<sup>3</sup> South Farm

Tidal Company

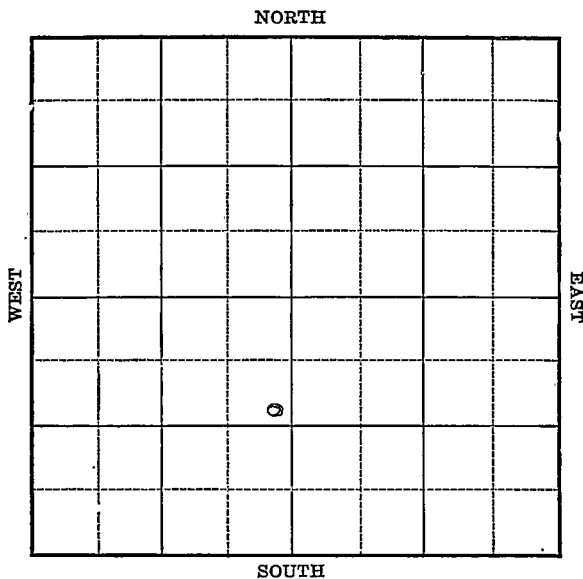

Location \_\_\_\_\_

Drilling Remarks

\_\_\_\_\_

\_\_\_\_\_

Rig Up \_\_\_\_\_

Drilling Remarks

\_\_\_\_\_

\_\_\_\_\_

**RECORD**

Cased \_\_\_\_\_ in. \_\_\_\_\_ ft.

Sand \_\_\_\_\_

Gas \_\_\_\_\_

Oil \_\_\_\_\_

Total Depth \_\_\_\_\_

**PRODUCTION**

1st 24 hrs. Nat. \_\_\_\_\_

1st. 24 hrs. after shot \_\_\_\_\_

Gas \_\_\_\_\_ cu. ft.

Dry Hole \_\_\_\_\_

Abandoned \_\_\_\_\_



21 **KANSAS** Map No. Sec. 22 Twp. 22 R. 11

Well No. 4 South

Tidal Company

Contractor

**FIRST REPORT**

**SECTION PLAT**

990 Ft. from N. Line

Ft. from S. Line

330 Ft. from E. Line

Ft. from W. Line


Location -----

Rig up -----

Drilling and Remarks:

**RECORD**

Cased ----- in., ----- ft.

Sand -----

Gas -----

Oil -----

Total Depth -----

**PRODUCTION**

1st 24 hrs. Nat. -----

1st 24 hrs. after shot -----

Gas ----- Cu. Ft.

Dry Hole -----

Abandoned -----

Date

DEC 11 1924

192

M. A. BENEAR

Scout

Map No. 21 **KANSAS** Sec. 22 Twp. 22 R. 11

Well No. X<sup>3</sup> South

Tulsa Oil Company

Contractor

**COMPLETED SECTION PLAT**

996 Ft. from N. Line

\_\_\_\_\_ Ft. from S. Line

330 Ft. from E. Line

\_\_\_\_\_ Ft. from W. Line

	0		

Location \_\_\_\_\_

Rig up \_\_\_\_\_

Drilling and Remarks:

sand 1905-71  
100/15 flb

**RECORD**

Cased \_\_\_\_\_ in., \_\_\_\_\_ ft.

Sand \_\_\_\_\_

Gas \_\_\_\_\_

Oil \_\_\_\_\_

Total Depth \_\_\_\_\_

**PRODUCTION**

1st 24 hrs. Nat. \_\_\_\_\_

1st 24 hrs. after shot \_\_\_\_\_

Gas \_\_\_\_\_ Cu. Ft.

Dry Hole \_\_\_\_\_

Abandoned \_\_\_\_\_

Date

1/14 1925

**M. A. BENEAR**

Scout